

MISSISSIPPI DEPARTMENT OF NATURAL RESOURCES

Bureau of Land and Water Resources

Southport Mall

P.O. Box 10631

Jackson, Mississippi 39209

WATER WELL DRILLERS LOG

PIKE
L
2056

1-18
date well completed

1985 Fitzgerald Sewer
firm name

Pike
county well located

LANDOWNER:	description of formations encountered	from	to
Delores Burnfield R.R. Magnolia ms. (mailing address)			
WELL LOCATION: sec. 14 T-1 N R-8 E S W 3 miles WNW of Rogers (distance) (direction) (nearest town)			
WELL PURPOSE: (home, irrigation, municipal, industrial)			
WELL COMPLETION DATA:			
(1) diameter (inches) 4			
(2) total depth (feet) 95			
(3) static water level (feet) 55 below top of ground.			
(4) casing PVC, 87, (material) (depth) 4 (size) if telescope see back.			
(5) screen 8, 87 (length) (depth to top) 4 (size) PVC (material)			
(6) pump 1/2, 10 (HP) (yield gpm) Elec (type power)			
(7) electric log no (yes or no) (organization running log)			
(8) how well bottom plugged Sand			

RECEIVED


MAR 5 - 1985

DRILLERS REMARKS:

Department of Natural Resources
Bureau of Land & Water Resources

If well telescopes please sketch and show depths.

GROUND LEVEL

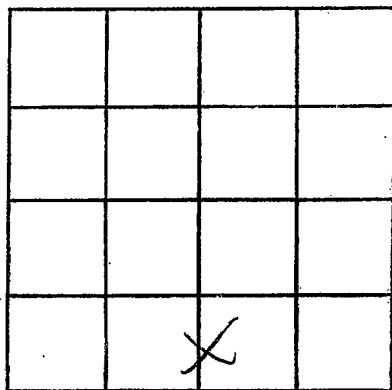

SECTION 14

Please indicate well location X.

ADDITIONAL INFORMATION

If more than one screen, show locations of each on sketch.