

MISSISSIPPI DEPARTMENT OF NATURAL RESOURCES

Bureau of Land and Water Resources

Southport Mall

P.O. Box 10631

Jackson, Mississippi 39209

WATER WELL DRILLERS LOG

Pike
L 2057
5-21-85

5-21 1985 date well completed
Fitzgerald Well Service, Inc. firm name
Pike county well located

LANDOWNER:	description of formations encountered	from	to
Mary Johnson R.B. Magnolia, Mrs. (mailing address)			
WELL LOCATION:			
sec. 25 T. 1 N. R. 8 E S W			
2 miles SW of Progress (distance) (direction) (nearest town)			
WELL PURPOSE: floor (home, irrigation, municipal, industrial)			
WELL COMPLETION DATA:			
(1) diameter (inches) 4			
(2) total depth (feet) 115			
(3) static water level (feet) 60 below top of ground.			
(4) casing PVC, 105 (material) (depth) 4 (size) if telescope see back.			
(5) screen 10, 105 (length) (depth to top) 4 (size) PVC (material)			
(6) pump 1/2, 10 (HP) (yield gpm) Elec (type power)			
(7) electric log No (yes or no) (organization running log)			
(8) how well bottom plugged Seal Seal			

RECEIVED


JUL 22 1985

DRILLERS REMARKS:

Department of Natural Resources
Bureau of Land & Water Resources

If well telescopes please sketch and show depths.

GROUND LEVEL

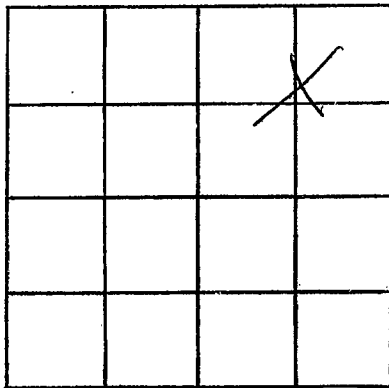

SECTION 25

Please indicate well location X.

ADDITIONAL INFORMATION

If more than one screen,
show locations of each on sketch.