

MISSISSIPPI DEPARTMENT OF NATURAL RESOURCES

Bureau of Land and Water Resources

Southport Mall

P.O. Box 10631

Jackson, Mississippi 39209

WATER WELL DRILLERS LOG

L 2058
 Pike
 7-31-85

7-31 1985 Fitzgerald Well Serv Pike
 date well completed firm name county well located

LANDOWNER:
Ernest Richards
R.R. Osyden, ms.
 (mailing address)

description of formations encountered	from	to
<u>Red clay</u>	<u>0</u>	<u>20</u>
<u>Red sand</u>	<u>20</u>	<u>90</u>
<u>Coarse sand & gravel</u>	<u>90</u>	<u>135</u>

WELL LOCATION:
 sec. 32 1 N R 8 E
 S W
3 miles E of Osyden
 (distance) (direction) (nearest town)

WELL PURPOSE: Home
 (home, irrigation, municipal, industrial)

WELL COMPLETION DATA:

(1) diameter (inches) 4

(2) total depth (feet) 135

(3) static water level (feet) 80 below above top of ground.

(4) casing PVC, 125
 (material) (depth)
4 if telescope see back.
 (size)

(5) screen 10, 125
 (length) (depth to top)
4, PVC
 (size) (material)

(6) pump 3/4, 15
 (HP) (yield gpm)
Electric
 (type power)

(7) electric log no
 (yes or no)
 (organization running log)

(8) how well bottom plugged Seal Pk

RECEIVED


SEP 13 1985

Department of Natural Resources
 Bureau of Land & Water Resources

DRILLERS REMARKS:

If well telescopes please sketch and show depths.

GROUND LEVEL

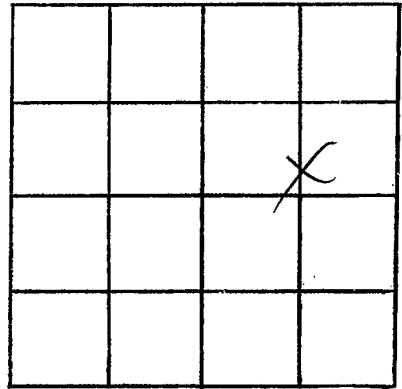

SECTION 32

Please indicate well location X.

ADDITIONAL INFORMATION

If more than one screen,
show locations of each on sketch.