

MISSISSIPPI DEPARTMENT OF NATURAL RESOURCES
 Bureau of Land and Water Resources
 Southport Mall
 P.O. Box 10631
 Jackson, Mississippi 39209
WATER WELL DRILLERS LOG

HEATH
PIKE
L 2009

10-11 1985 Fitzgerald Well Serv Pike
 date well completed firm name county well located

LANDOWNER:

Daniel Vandone

R.B. Oyster, Jr.
 (mailing address)

description of formations encountered

from

to

<u>Red clay</u>	<u>0</u>	<u>20</u>
<u>Red sand</u>	<u>20</u>	<u>100</u>
<u>Coarse sand & gravel</u>	<u>100</u>	<u>115</u>

WELL LOCATION:

sec. 20 T. 1 N R. 8 E
 S W
3 miles EKE of Osyka
 (distance) (direction) (nearest town)

WELL PURPOSE:

Home
 (home, irrigation, municipal, industrial)

WELL COMPLETION DATA:

- (1) diameter (inches) 4
- (2) total depth (feet) 115
- (3) static water level (feet) 50 below above top of ground.
- (4) casing PVC, 105,
 (material) (depth)
4
 (size) if telescope see back.
- (5) screen 10, 105
 (length) (depth to top)
4, PVC
 (size) (material)
- (6) pump 1/2, 10
 (HP) (yield gpm)
Electric
 (type power)
- (7) electric log no
 (yes or no)
Electric
 (organization running log)
- (8) how well bottom plugged Sealed

RECEIVED


NOV - 5 1985

DRILLERS REMARKS:

Department of Natural Resources
 Bureau of Land & Water Resources

If well telescopes please sketch and show depths.

GROUND LEVEL

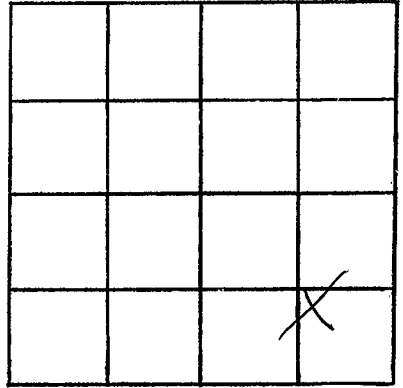

SECTION 20

Please indicate well location X.

ADDITIONAL INFORMATION

If more than one screen,
show locations of each on sketch.