

PIKE
L 2000

MISSISSIPPI DEPARTMENT OF NATURAL RESOURCES
Bureau of Land and Water Resources
Southport Mall
P.O. Box 10631
Jackson, Mississippi 39209
WATER WELL DRILLERS LOG

8-21 1986 Flycatcher Sew Pike
date well completed firm name county well located


LANDOWNER:
Mr. A. Mook
R.R. Osyka, Jr.
(mailing address)

| description of formations encountered | from | to |
|---------------------------------------|------------|------------|
| <u>Red clay</u> | <u>0</u> | <u>20</u> |
| <u>Red stone</u> | <u>20</u> | <u>145</u> |
| <u>Coarse sand & gravel</u> | <u>145</u> | <u>160</u> |

WELL LOCATION:
sec. 3 T 1 N R 8 E
S W
1 miles S of Bull
(distance) (direction) (nearest town)

WELL PURPOSE: Home
(home, irrigation, municipal, industrial)

- WELL COMPLETION DATA:
- (1) diameter (inches) 4
 - (2) total depth (feet) 160
 - (3) static water level (feet) 76 below above top of ground.
 - (4) casing PC 150, 150
(material) (depth)
4 if telescope see back.
(size)
 - (5) screen 10, 150
(length) (depth to top)
4, PC
(size) (material)
 - (6) pump 1/2, 10
(HP) (yield gpm)
Elc
(type power)
 - (7) electric log No
(yes or no)
Elc
(organization running log)
 - (8) how well bottom plugged Seal

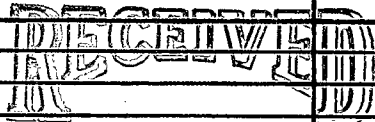


SEP 3 0 1986

DRILLERS REMARKS:

Department of Natural Resources
Bureau of Land & Water Resources

If well telescopes please sketch and show depths.

GROUND LEVEL

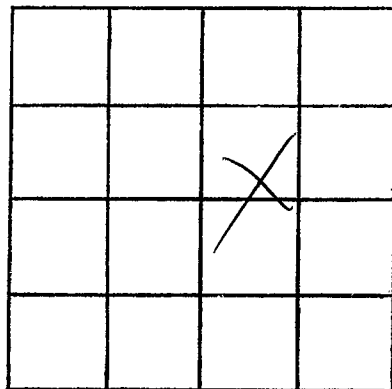

SECTION 3

Please indicate well location X.

ADDITIONAL INFORMATION

If more than one screen, show locations of each on sketch.