

MISSISSIPPI DEPARTMENT OF NATURAL RESOURCES

Bureau of Land and Water Resources

Southport Mall

P.O. Box 10631

Jackson, Mississippi 39209

WATER WELL DRILLERS LOG

PIKE
L2003

Jan 8 1987 Stuffed Water Well Pike
 date well completed firm name county well located

LANDOWNER: Rilly Husgust
Rt. 1
Osgood MS 39659
 (mailing address)

WELL LOCATION:
 sec. 29 T. 1 N. R. 8 E.
S W
6 miles North of Osgood
 (distance) (direction) (nearest town)

WELL PURPOSE: Domestic
 (home, irrigation, municipal, industrial)

- WELL COMPLETION DATA:
- (1) diameter (inches) 4"
 - (2) total depth (feet) 170'
 - (3) static water level (feet) 47' below top of ground.
 - (4) casing plastic, 170'
 (material) (depth)
 (size) if telescope see back.
 - (5) screen 10', 110'
 (length) (depth to top)
4", plastic
 (size) (material)
 - (6) pump 1/2, 9'
 (HP) (yield gpm)
electric
 (type power)
 - (7) electric log
 (yes or no)

 (organization running log)
 - (8) how well bottom plugged sand shark

description of formations encountered	from	to
top soil	0	1'
Red Brown clay	1'	10'
sand & gravel	10'	30'
Red clay	30'	75'
Sand	75'	90'
pink clay	90'	105'
sand & gravel	105'	175'

RECEIVED


FEB 10 1987

Department of Natural Resources
 Bureau of Land & Water Resources

DRILLERS REMARKS:

If well telescopes please sketch and show depths.

GROUND LEVEL

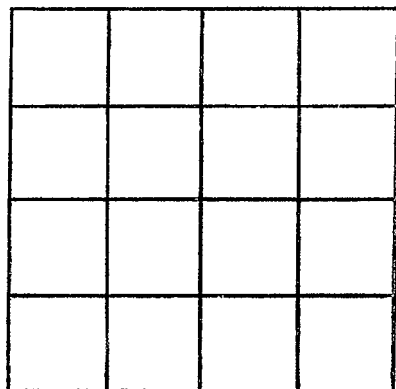

SECTION _____

Please indicate well location X.

ADDITIONAL INFORMATION

If more than one screen, show locations of each on sketch.