

MISSISSIPPI DEPARTMENT OF NATURAL RESOURCES

Bureau of Land and Water Resources

Southport Mall

P.O. Box 10631

Jackson, Mississippi 39209

WATER WELL DRILLERS LOG

PIKE
L 2066

1-28 1987
date well completed

87 Fitzgerald Sew
firm name

Pike
county well located

LANDOWNER:	description of formations encountered	from	to
John Smith P.O. Magnolia, MS. (mailing address)			
WELL LOCATION:			
sec. 9 T 1 N R 8 E S W			
1 miles S of Ball (distance) (direction) (nearest town)			
WELL PURPOSE: Home (home, irrigation, municipal, industrial)			
WELL COMPLETION DATA:			
(1) diameter (inches) 4			
(2) total depth (feet) 112			
(3) static water level (feet) 80 below top of ground. above			
(4) casing PVC, 102 (material) (depth) 4 (size) if telescope see back.			
(5) screen 10, 102 (length) (depth to top) 4, PVC (size) (material)			
(6) pump 1/2 10 (HP) (yield gpm) Elec (type power)			
(7) electric log No (yes or no) (organization running log)			
(8) how well bottom plugged Sealed			

RECEIVED


FEB 12 1987

Department of Natural Resources
Bureau of Land & Water Resources

DRILLERS REMARKS:

If well telescopes please sketch and show depths.

GROUND LEVEL

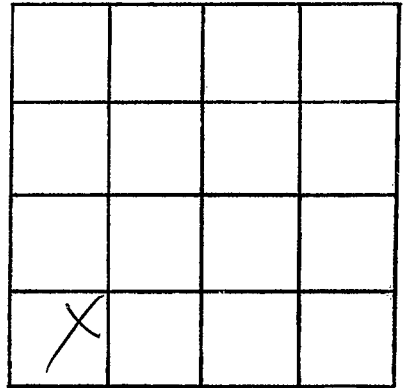

SECTION 9

Please indicate well location X.

ADDITIONAL INFORMATION

If more than one screen,
show locations of each on sketch.