

MISSISSIPPI DEPARTMENT OF NATURAL RESOURCES

Bureau of Land and Water Resources

Southport Mall

P.O. Box 10631

Jackson, Mississippi 39209

WATER WELL DRILLERS LOG

PIKE
L 2006

5-20 1987 Flycatcher Well Ser Pike
date well completed firm name county well located

LANDOWNER:	description of formations encountered	from	to
<u>Gay Ziegler</u>	<u>Reel clay</u>	<u>0</u>	<u>20</u>
<u>R.B. Mazurkin, Inc.</u> (mailing address)	<u>Reel sand</u>	<u>20</u>	<u>80</u>
<u>WELL LOCATION:</u> sec. <u>18</u> T <u>1</u> N R <u>8</u> E S W	<u>Reel sand + gravel</u>	<u>80</u>	<u>119</u>
<u>6</u> miles <u>S</u> of <u>Mazurkin</u> (distance) (direction) (nearest town)	<u>Coarse sand + gravel</u>	<u>119</u>	<u>130</u>
<u>WELL PURPOSE:</u> <u>Home</u> (home, irrigation, municipal, industrial)			
<u>WELL COMPLETION DATA:</u>			
(1) diameter (inches) <u>4</u>			
(2) total depth (feet) <u>130</u>			
(3) static water level (feet) <u>100</u> below above top of ground.			
(4) casing <u>WC</u> <u>120</u> (material) (depth)			
<u>4</u> if telescope see back. (size)			
(5) screen <u>1/2</u> <u>10</u> (length) (depth to top)			
<u>4</u> <u>WC</u> (size) (material)			
(6) pump <u>1/2</u> <u>10</u> (HP) (yield gpm)			
<u>Electric</u> (type power)			
(7) electric log <u>no</u> (yes or no)			
(organization running log)			
(8) how well bottom plugged <u>Sand plug</u>			


RECEIVED
APR 16 1987
 Bureau of Land and Water Resources
 Department of Natural Resources
 Jackson, Mississippi

RECEIVED
 JUN 16 1987
 Bureau of Land and Water Resources
 Department of Natural Resources
 Jackson, Mississippi

DRILLERS REMARKS:

If well telescopes please sketch and show depths.

GROUND LEVEL

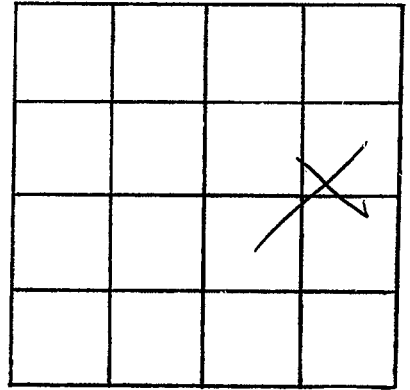

SECTION 18

Please indicate well location X.

ADDITIONAL INFORMATION

If more than one screen,
show locations of each on sketch.