

MISSISSIPPI DEPARTMENT OF NATURAL RESOURCES

Bureau of Land and Water Resources

Southport Mall

P.O. Box 10631

Jackson, Mississippi 39209

WATER WELL DRILLERS LOG


TKR
L 2007

7-22 19 *87*
 date well completed

Fitzgerald & Sons
 firm name

Pike
 county well located

LANDOWNER:	description of formations encountered	from	to
<i>James McClain</i> <i>- RR. 254 ms.</i> (mailing address)			
WELL LOCATION:			
sec. <i>25</i> T. <i>1</i> N. R. <i>8</i> E S W			
<i>3</i> miles <i>SW</i> of <i>Priggins</i> (distance) (direction) (nearest town)			
WELL PURPOSE: (home, irrigation, municipal, industrial)			
WELL COMPLETION DATA:			
(1) diameter (inches) <i>4</i>			
(2) total depth (feet) <i>115</i>			
(3) static water level (feet) <i>70</i> below/above top of ground.			
(4) casing <i>PVC</i> , <i>105</i> (material) (depth) <i>4</i> if telescope see back. (size)			
(5) screen <i>10</i> , <i>105</i> (length) (depth to top) <i>4</i> , <i>PVC</i> (size) (material)			
(6) pump <i>1/2</i> , <i>70</i> (HP) (yield gpm) <i>Elm</i> (type power)			
(7) electric log <i>No</i> (yes or no) <i>(organization running log)</i>			
(8) how well bottom plugged <i>Sealed</i>			

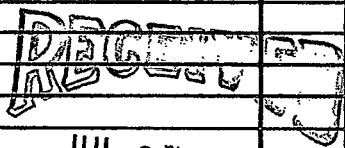

MAR 27 1987

Department of Natural Resources
 Bureau of Land & Water Resources

DRILLERS REMARKS:

If well telescopes please sketch and show depths.

GROUND LEVEL

		X	

SECTION 25

Please indicate well location X.

ADDITIONAL INFORMATION

If more than one screen,
show locations of each on sketch.