

PIKE  
L  
2009

MISSISSIPPI DEPARTMENT OF NATURAL RESOURCES  
Bureau of Land and Water Resources  
Southport Mall  
P.O. Box 10631  
Jackson, Mississippi 39209  
WATER WELL DRILLERS LOG

11/5 19 87 AMITE PUMP & WELL SUPPLY PIKE  
date well completed firm name county well located

LANDOWNER: IRWIN WILLIAMS	description of formations encountered	from	to
RT. 1 BOX 370	clay	0	30
OSYKA, MS. 39657 (mailing address)	sand/gravel	30	75
WELL LOCATION: on back sec. <u>24</u> T. <u>1</u> N. <u>5</u> R. <u>2</u> E. <u>W</u> _____ miles _____ of _____ (distance) (direction) (nearest town)			
WELL PURPOSE: home (home, irrigation, municipal, industrial)			
WELL COMPLETION DATA:			
(1) diameter (inches) <u>4</u>			
(2) total depth (feet) <u>80</u>			
(3) static water level (feet) <u>40</u> below top of ground. above			
(4) casing <u>sch 40</u> , <u>70</u> (material) (depth)			
_____ if telescope see back. (size)			
(5) screen <u>10</u> , <u>80</u> (length) (depth to top)			
<u>014</u> , sch pvc <u>014</u> (size) (material)			
(6) pump $\frac{1}{2}$ sub. <u>10</u> (HP) (yield gpm)			
<u>220</u> (type power)			
(7) electric log <u>no</u> (yes or no)			
_____ (organization running log)			
(8) how well bottom plugged <u>back</u> <u>wash valve</u>			

RECEIVED  
NOV 15 1987


DEC 16 1987

Department of Natural Resources  
Bureau of Land & Water Resources

DRILLERS REMARKS:

If well telescopes please sketch and show depths.

GROUND LEVEL

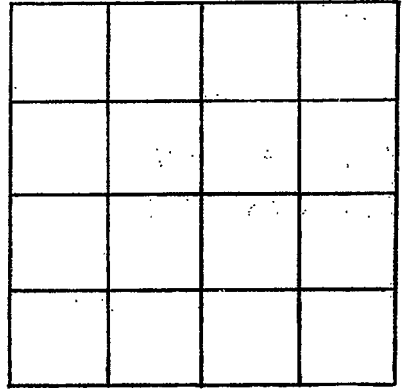

SECTION \_\_\_\_\_

Please indicate well location X.

**ADDITIONAL INFORMATION**

OSYKA TURN RIGHT ON PROGR  
ROAD GO ABOUT 6 MILES CROSS  
3 BRIDGES TURN RIGHT ON HILL  
IN CURVE SEE MT. ZION CHURCH  
GO STRAIGHT 4TH HOUSE TURN  
left- cross bridge-trailer  
on left

If more than one screen,  
show locations of each on sketch.