

PIKE
 L
 2074

MISSISSIPPI DEPARTMENT OF NATURAL RESOURCES
 Bureau of Land and Water Resources
 Southport Mall
 P.O. Box 10631
 Jackson, Mississippi 39209
WATER WELL DRILLERS LOG

Aug 13 1990 F. Fitzgerald West Serv Pike
 date well completed firm name county well located

LANDOWNER:	description of formations encountered	from	to
<u>Fernwood Land.</u>			
<u>P.O. Box Fernwood ms.</u> (mailing address)	<u>SAND & gravel</u>	<u>10</u>	<u>45</u>

WELL LOCATION:
 sec. 31 T-1 N R-8 E
 S W
1/2 miles E of Fernwood
 (distance) (direction) (nearest town)

WELL PURPOSE: MONITOR
 (home, irrigation, municipal, industrial)

- WELL COMPLETION DATA:
- (1) diameter (inches) 4
 - (2) total depth (feet) 45
 - (3) static water level (feet) 14 below above top of ground.
 - (4) casing Stainless Steel 10,
 (material) (depth)
4 if telescope see back.
 (size)
 - (5) screen 35 10
 (length) (depth to top)
4 Stainless Steel
 (size) (material)
 - (6) pump Boiler-
 (HP) (yield gpm)
1/2HP
 (type power)
 - (7) electric log No
 (yes or no)
 (organization running log)
 - (8) how well bottom plugged Sealhh

RECEIVED


SEP 27 1990

Department of Natural Resources
 Bureau of Land & Water Resources

DRILLERS REMARKS:

If well telescopes please sketch and show depths.

GROUND LEVEL

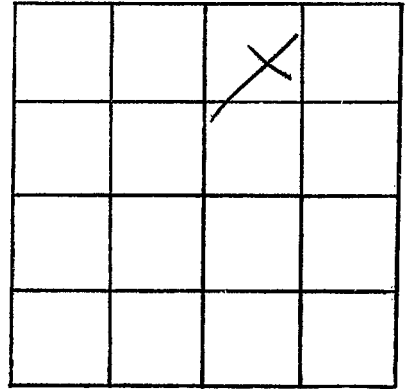

SECTION 31

Please indicate well location X.

ADDITIONAL INFORMATION

If more than one screen,
show locations of each on sketch.