

**MISSISSIPPI DEPARTMENT OF ENVIRONMENTAL QUALITY**  
Bureau of Land and Water Resources

P. O. Box 10631  
Jackson, MS 39289-0631  
**WATER WELL DRILLERS LOG**

COUNTY WELL LOCATED <i>Pike</i>	
WELL NUMBER <i>L</i>	CODED
DATE WELL COMPLETED <i>2009</i> <i>7-22-91</i>	

PERMIT NUMBER
NAME OF DRILLING FIRM <i>FITZGERALD Well Serv</i>

NAME & MAILING ADDRESS OF LANDOWNER <i>Ferry Morton</i> <i>P.R. Magnolia ms.</i>		
WELL LOCATION: SEC	TOWNSHIP	RANGE
<i>24</i>	<i>1</i>	<i>N 8 E</i>
DISTANCE	DIRECTION	NEAREST TOWN
<i>3</i> Miles	<i>SW</i>	<i>Progers</i>
OTHER LANDMARK		
WELL PURPOSE: Home, Irrigation, Municipal, Industrial, Fish Pond, etc. <i>Home</i>		

<b>PUMP DATA</b>		
PUMP TYPE (Circle One): Submersible, Turbine, Jet, Flowing Well, Other (Describe) _____		
POWER TYPE (Circle One): Electric, Tractor, Diesel, Gasoline, Butane, Other (Describe) _____ H/P _____		
Pump Capacity (GPM) <i>10</i>	No. of Stages <i>8</i>	Setting Depth <i>80</i> FT.
PUMP TEST		
Well yielded <i>25</i> GPM with a drawdown of <i>2</i> ft. after <i>1</i> hours of pumping		

<b>WELL DATA</b>		
Well Depth <i>100</i>	Casing Diameter (In.) <i>4</i>	Casing Length (Ft.) <i>90</i>
Type of Casing <i>PVC</i>	Hole Depth <i>100</i>	Depth to Static Water Level <i>53</i>
TYPE OF COMPLETION: (Circle One or More): <input checked="" type="checkbox"/> Gravel Packed, <input type="checkbox"/> Underreamed, <input type="checkbox"/> Telescoped, <input type="checkbox"/> Natural Development, <input type="checkbox"/> Open Hole, <input type="checkbox"/> Other		
Top of Lap Pipe or Reduction in Casing  FEET IF TELESCOPED OR MORE THAN ONE SCREEN: USE BACK PAGE		

<b>LOG DATA</b>	
TYPE OF LOG RUN (Circle One): Electric, Gamma Ray, Density, Sonic, Neutron, Other (Describe) _____	
Name of Organization Running Log <i>No Log Run</i>	

<b>SCREEN DATA</b>		
Diameter - Inches <i>4</i>	Length - Feet <i>10</i>	Slot Size - Inches <i>1014</i>
Screen Type <i>PVC</i>	Depth to Bottom - Feet <i>100</i>	

<b>GEOLOGIC DATA (Office Use Only)</b>			
Surface Elev.	Geologic Unit	Unit Thickness	Depth to Top
Subs. SWL	Date	Analysis	Aquifer Test
Driller's Remarks			


DESCRIPTION OF FORMATIONS ENCOUNTERED	FROM	TO	FORMATIONS (Continued)	FROM	TO
<i>Red Clay</i>	<i>0</i>	<i>15</i>			
<i>Red Sand</i>	<i>15</i>	<i>82</i>			
<i>Coarse Sand &amp; gravel</i>	<i>82</i>	<i>100</i>			

**RECEIVED**  
**AUG 08 1991**  
Dept. of Environmental Quality  
Bureau of Land & Water Resources

IF MORE SPACE IS NEEDED, USE BACK

If well telescopes please  
sketch and show depths.

GROUND LEVEL

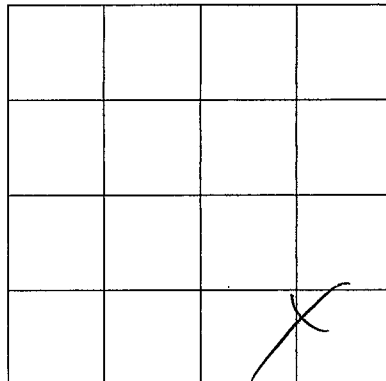

SECTION 24

Please indicate well location X.

ADDITIONAL INFORMATION

If more than one screen,  
show location of each on sketch.