

**MISSISSIPPI DEPARTMENT OF ENVIRONMENTAL  
QUALITY**

Office of Land and Water Resources

P. O. Box 10631  
Jackson, MS 39289-0631  
**WATER WELL DRILLERS LOG**

COUNTY WELL LOCATED <u>D.R.C.</u>	
WELL NUMBER <u>2</u>	CODED
DATE WELL COMPLETED <u>2088</u> <u>Aug 22 94</u>	

PERMIT NUMBER
NAME OF DRILLING FIRM <u>FITZGERALD well serv</u>

NAME & MAILING ADDRESS OF LANDOWNER <u>William ANDERSON</u>			
<u>RR. OSYKA MS</u>			
WELL LOCATION:	SEC	TOWNSHIP	RANGE
	<u>7</u>	<u>1</u>	<u>N 8 E</u>
DISTANCE	DIRECTION	NEAREST TOWN	
<u>6</u> Miles	<u>SSE</u>	<u>MAGNOLIA</u>	
OTHER LANDMARK			
WELL PURPOSE: Home, Irrigation, Municipal, Industrial, Fish Pond, etc. <u>Home</u>			

<b>PUMP DATA</b>			
PUMP TYPE (Circle One): <u>Submersible</u> , Turbine, Jet, Flowing Well, Other (Describe) _____			
POWER TYPE (Circle One): <u>Electric</u> , Tractor, Diesel, Gasoline, Butane, Other (Describe) _____ H/P <u>1/2</u>			
Pump Capacity (GPM) <u>10</u>	No. of Stages <u>8</u>	Setting Depth <u>90</u>	FT.
PUMP TEST			
Well yielded <u>25</u> GPM with a drawdown of <u>2</u> ft. after <u>2</u> hours of pumping			

<b>WELL DATA</b>		
Well Depth <u>107</u>	Casing Diameter (In.) <u>4</u>	Casing Length (Ft.) <u>97</u>
Type of Casing <u>P.C.</u>	Hole Depth <u>107</u>	Depth to Static Water Level <u>69</u>
TYPE OF COMPLETION: (Circle One or More): <u>Gravel Packed</u> , Underreamed, Telescoped, <del>Natural Development</del> , Open Hole, Other (Describe) _____		

<b>LOG DATA</b>	
TYPE OF LOG RUN (Circle One): <u>No Log Run</u> , Electric, Gamma Ray, Density, Sonic, Neutron, Other (Describe) _____	
Name of Organization Running Log	

WELL GROUTED TO A DEPTH OF <u>0</u> FEET Type Grout (circle one): Cement, Bentonite, or <u>MIX</u>
---

<b>GEOLOGIC DATA (Office Use Only)</b>			
Surface Elev.	Geologic Unit	Unit Thickness	Depth to Top
Subs. SWL	Date	Analysis	Aquifer Test

<b>SCREEN DATA</b>		
Diameter - Inches <u>4</u>	Length - Feet <u>10</u>	Slot Size - Inches <u>10/10</u>
Screen Type <u>P.C.</u>	Depth to Bottom - Feet <u>107</u>	


Driller's Remarks	
Top of Lap Pipe or Reduction in Casing	
FEET	IF TELESCOPED OR MORE THAN ONE SCREEN: USE BACK PAGE

DESCRIPTION OF FORMATIONS ENCOUNTERED	FROM	TO
<u>Red Clay</u>	<u>0</u>	<u>20</u>
<u>Red Sand</u>	<u>20</u>	<u>94</u>
<u>Coarse Sand &amp; gravel</u>	<u>94</u>	<u>107</u>

FORMATIONS (Continued)	FROM	TO
<b>RECEIVED</b>		
<b>OCT 14 1994</b>		
Dept. of Environmental Quality Office of Land & Water Resources		
IF MORE SPACE IS NEEDED, USE BACK		

If well telescopes please sketch and show depths.

GROUND LEVEL

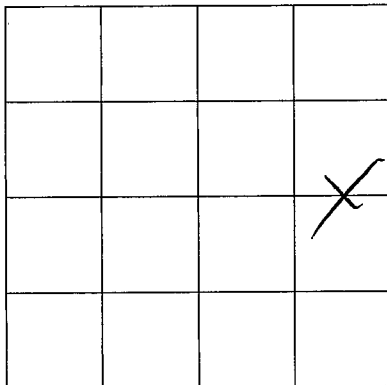

SECTION 7

Please indicate well location X.

ADDITIONAL INFORMATION

If more than one screen,  
show location of each on sketch.