

PIKE
L 2107

MISSISSIPPI DEPARTMENT OF NATURAL RESOURCES
Bureau of Land and Water Resources
Southport Mall
P.O. Box 10631
Jackson, Mississippi 39209
WATER WELL DRILLERS LOG

8-30 1996 AMITE PUMP & WELL PIKE
date well completed firm name county well located

LANDOWNER: CAPDEBOSCO, B.
7767 O'QUINN RD.
OSYKA, MS.
(mailing address)

description of formations encountered	from	to
SAND	0	20
sand/gravel	20	30
sand/large gravel	30	40
sand	40	50
clay	50	98
gravel	98	110

WELL LOCATION:
sec. 35 T 1 N R 8 E
4 miles E of OSYKA
(distance) (direction) (nearest town)

WELL PURPOSE: HOME
(home, irrigation, municipal, industrial)

WELL COMPLETION DATA:

- (1) diameter (inches) 4
- (2) total depth (feet) 110
- (3) static water level (feet) 35 X below above top of ground.
- (4) casing sch 40, 100
(material) (depth)
4 If telescope see back.
(size)
- (5) screen 10, 100
(length) (depth to top)
014, sch 40 pvc
(size) (material)
- (6) pump .5hp, 10
(HP) (yield gpm)
220
(type power)
- (7) electric log NO
(yes or no)
(organization running log)
- (8) how well bottom plugged BACKWASH VALVE

RECEIVED


OCT 29 1996

Dept. of Environmental Quality
Office of Land & Water Resources

DRILLERS REMARKS:

If well telescopes please sketch and show depths.

GROUND LEVEL

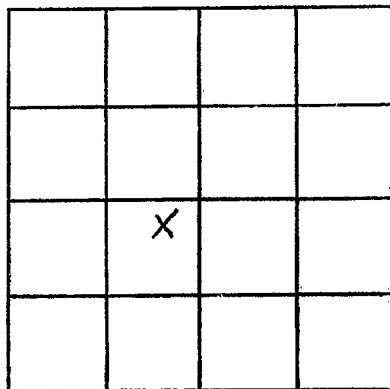

SECTION 35

Please indicate well location X.

ADDITIONAL INFORMATION

If more than one screen,
show locations of each on sketch.