

MISSISSIPPI DEPARTMENT OF ENVIRONMENTAL QUALITY

Office of Land and Water Resources

P. O. Box 10631
Jackson, MS 39289-0631
WATER WELL DRILLERS LOG

COUNTY WELL LOCATED <i>Pike</i>	
WELL NUMBER <i>L 2113</i>	CODED
DATE WELL COMPLETED <i>6-23-07</i>	

PERMIT NUMBER
NAME OF DRILLING FIRM <i>Enterprise Well</i>

NAME & MAILING ADDRESS OF LANDOWNER <i>Pete Snyder</i> <i>RR Magnolia</i>			
WELL LOCATION:	SEC <i>10</i>	TOWNSHIP <i>1</i>	RANGE <i>N 8 E</i> <i>S 8 W</i>
DISTANCE <i>8</i> Miles	DIRECTION <i>E</i>	NEAREST TOWN <i>Magnolia</i>	
OTHER LANDMARK			
WELL PURPOSE (Home) <input checked="" type="checkbox"/> Irrigation, Municipal, Industrial, Fish Pond, etc.			

PUMP DATA		
PUMP TYPE (Circle One): <input checked="" type="checkbox"/> Submersible, Turbine, Jet, Flowing Well, Other (Describe) _____		
POWER TYPE (Circle One): <input checked="" type="checkbox"/> Electric, Tractor, Diesel, Gasoline, Butane, Other (Describe) _____ H/P <i>1/2</i>		
Pump Capacity (GPM) <i>12</i>	No. of Stages <i>9</i>	Setting Depth <i>56</i> FT.
PUMP TEST		
Well yielded <i>50</i> GPM with a drawdown of <i>1</i> ft. after <i>1</i> hours of pumping		

WELL DATA		
Well Depth <i>98</i>	Casing Diameter (In.) <i>4"</i>	Casing Length (Ft.) <i>88"</i>
Type of Casing <i>PVC</i>	Hole Depth <i>98"</i>	Depth to Static Water Level <i>24"</i>
TYPE OF COMPLETION: (Circle One or More): <input checked="" type="checkbox"/> Gravel Packed, Underreamed, Telescoped, Natural Development, Open Hole, Other (Describe) _____		

LOG DATA	
TYPE OF LOG RUN (Circle One): Electric, Gamma Ray, Density, Sonic, <input checked="" type="checkbox"/> No Log Run, Neutron, Other (Describe) _____	
Name of Organization Running Log	

WELL GROUTED TO A DEPTH OF *10* FEET
Type Grout (circle one): Cement, Bentonite, Gr. Mix

GEOLOGIC DATA (Office Use Only)			
Surface Elev.	Geologic Unit	Unit Thickness	Depth to Top
Subs. SWL	Date	Analysis	Aquifer Test

SCREEN DATA		
Diameter - Inches <i>4"</i>	Length - Feet <i>10</i>	Slot Size - Inches <i>0.12</i>
Screen Type <i>PVC</i>	Depth to Bottom - Feet <i>98"</i>	


Driller's Remarks	
Top of Lap Pipe or Reduction in Casing	
FEET	IF TELESCOPED OR MORE THAN ONE SCREEN: USE BACK PAGE

DESCRIPTION OF FORMATIONS ENCOUNTERED	FROM	TO	FORMATIONS (Continued)	FROM	TO
<i>top soil</i>	<i>0</i>	<i>5</i>	RECEIVED SEP 15 1997 Dept. of Environmental Quality Office of Land & Water Resources		
<i>clay</i>	<i>5</i>	<i>20</i>			
<i>sand & gravel</i>	<i>20</i>	<i>60</i>			
<i>clay</i>	<i>60</i>	<i>70</i>			
<i>fine sand</i>	<i>70</i>	<i>78</i>			
<i>course sand</i>	<i>78</i>	<i>88</i>			

IF MORE SPACE IS NEEDED, USE BACK

If well telescopes please
sketch and show depths.

GROUND LEVEL

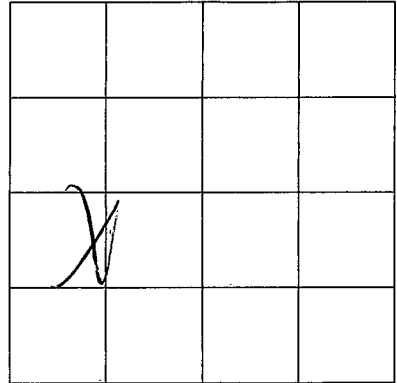

SECTION _____

Please indicate well location X.

ADDITIONAL INFORMATION

If more than one screen,
show location of each on sketch.