




If well telescopes please sketch and show depths.

GROUND LEVEL

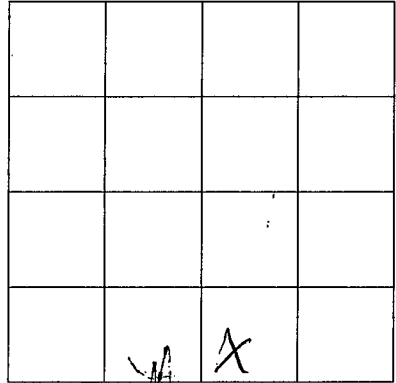


SECTION

20

Please indicate well location X.

ADDITIONAL INFORMATION

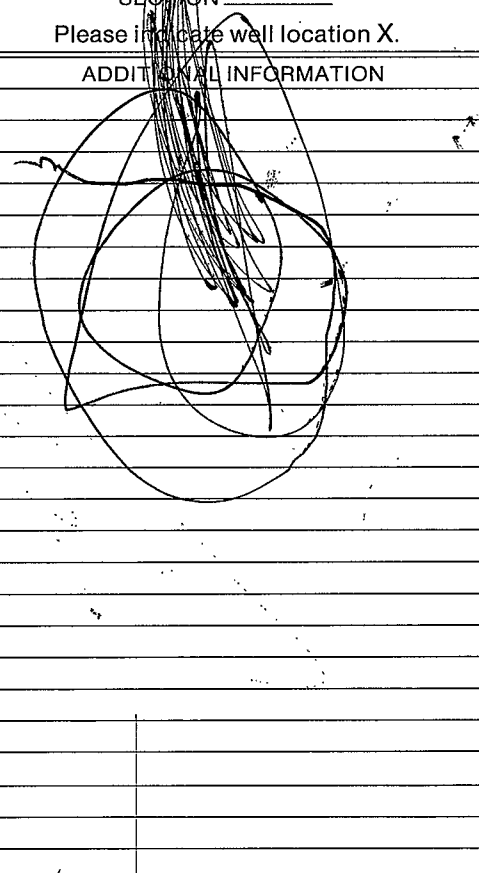

If more than one screen, show location of each on sketch.