

MISSISSIPPI DEPARTMENT OF ENVIRONMENTAL QUALITY
Office of Land and Water Resources

P. O. Box 10691

Jackson, MS 39289-0691

WATER WELL DRILLERS LOG

COUNTY WELL LOCATED <u>Pike</u>	
WELL NUMBER <u>L-2124</u>	CODED
DATE WELL COMPLETED <u>9-23-00</u>	

PERMIT NUMBER
NAME OF DRILLING FIRM <u>Amite Pump & Well</u>

NAME & MAILING ADDRESS OF LANDOWNER <u>Charles Sudkamp</u> <u>224 Devon Rd.</u> <u>La Place, La. 70068</u>			
WELL LOCATION	SEC <u>32</u>	TOWNSHIP <u>1</u>	RANGE <u>8</u> ^N _S ^E _W
DISTANCE <u>4 1/2</u>	DIRECTION <u>N</u>	NEAREST TOWN <u>Kentwood, La</u>	
OTHER LANDMARK <u>L on Foychase Rd.</u>			
WELL PURPOSE <u>Home, Irrigation, Municipal, Industrial, Fish Pond, etc.</u> <u>Camp</u>			

PUMP DATA		
PUMP TYPE (Circle One): <u>Did not install pump</u> Submersible, Turbine, Jet, Flowing Well, Other (Describe)		
POWER TYPE (Circle One): Electric, Tractor, Diesel, Gasoline, Butane, Other (Describe)		
Pump Capacity (GPM)	No. of Stages	Setting Depth <u>HP</u> FT.
PUMP TEST		
Well yielded _____ GPM with a drawdown of _____ ft. after _____ hours of pumping		

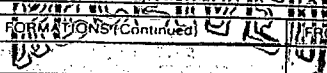
WELL DATA		
Well Depth <u>170'</u>	Casing Diameter (In.) <u>2"</u>	Casing Length (Ft.) <u>160</u>
Type of Casing <u>sch 40 pvc</u>	Hole Depth <u>170'</u>	Depth to Static Water Level <u>90'</u>
TYPE OF COMPLETION (Circle One or More): <u>Natural Development</u> , Gravel Packed, Underreamed, Telescoped, Open Hole, Other (Describe)		
WELL GROUTED TO A DEPTH OF <u>10</u> FEET Type Grout (circle one): <u>Cement</u> , Bentonite, or Mix		

LOG DATA	
TYPE OF LOG RUN (Circle One): No Log Run, Electric, Gamma Ray, Density, Sonic, Neutron, Other (Describe)	
Name of Organization Running Log	

SCREEN DATA		
Diameter - Inches <u>2</u>	Length - Feet <u>10</u>	Slot Size - Inches <u>1/8"</u>
Screen Type <u>sch 40 pvc</u>		Depth to Bottom - Feet

GEOLOGIC DATA (Office Use Only)			
Surface Elev	Geologic Unit	Unit Thickness	Depth to Top
Subs SWL	Date	Analysis	Aquifer Test
Driller's Remarks			
Top of Lap Pipe or Reduction in Casing			
IF TELESCOPED OR MORE THAN ONE SCREEN, USE BACK PAGE			

DESCRIPTION OF FORMATIONS ENCOUNTERED	FROM	TO
<u>clay</u>	<u>0</u>	<u>60</u>
<u>sand & gravel</u>	<u>60</u>	<u>80</u>
<u>clay</u>	<u>80</u>	<u>140</u>
<u>sand & gravel</u>	<u>140</u>	<u>170</u>


SEP 29 2000
 Dept of Environmental Quality
 Office of Land & Water Resources

1948

1949

1950