

MISSISSIPPI DEPARTMENT OF ENVIRONMENTAL QUALITY

Office of Land and Water Resources

P. O. Box 10631
Jackson, MS 39289-0631

WATER WELL DRILLERS LOG

COUNTY WELL LOCATED
Preps

WELL NUMBER
24

CODED

L-2135

DATE WELL COMPLETED
2-14-02

PERMIT NUMBER
879

NAME OF DRILLING FIRM
Revel Well Ser.

NAME & MAILING ADDRESS OF LANDOWNER
Dennis Taylor
Ed Brumfield Rd.

Latitude:
Longitude:

WELL LOCATION. SEC TOWNSHIP RANGE
27 1 S 8 W

DISTANCE DIRECTION NEAREST TOWN
10 Miles E of OSYKA

OTHER LANDMARK

WELL PURPOSE: Home, Irrigation, Municipal, Industrial, Fish Pond, etc.
Home

PUMP DATA

PUMP TYPE (Circle One):
Submersible Turbine, Jet Flowing Well, Other (Describe)

POWER TYPE (Circle One):
Electric, Tractor, Diesel, Gasoline, Butane, Other (Describe) H/P

DESCRIPTION OF FORMATIONS ENCOUNTERED	FROM	TO
<u>Clay</u>	<u>0</u>	<u>15</u>
<u>Red Chalk</u>	<u>15</u>	<u>50</u>
<u>Sand</u>	<u>50</u>	<u>70</u>
<u>Sand & Regravel</u>	<u>70</u>	<u>90</u>
<u>Red Chalk</u>	<u>90</u>	<u>100</u>
<u>sand & Regravel</u>	<u>100</u>	<u>130</u>

WELL DATA

Well Depth 130 Casing Diameter (In.) 4" Casing Length (Ft.) 20'

Type of Casing PVC Hole Depth 130 Depth to Static Water Level 60'

TYPE OF COMPLETION: (Circle One or More):
Gravel Packed, Underreamed, Telescoped, Natural Development, Open Hole, Other
(Describe) 10 Gravel Sand

WELL GROUTED TO A DEPTH OF 10 FEET
Type Grout (circle one): Cement, Bentonite, or Mix

SCREEN DATA

Diameter - Inches 4" Length - Feet 10' Slot Size - Inches 10 Mesh

Screen Type PVC Depth to Bottom - Feet 130'

RECEIVED

FEB 2002

BY: OLWR

Top of Lap Pipe or Reduction in Casing

FEET IF TELESCOPED OR MORE THAN ONE SCREEN: USE BACK PAGE

I certify that the well was drilled, constructed and completed in accordance with all applicable Requirements of the Mississippi Department of Environmental Quality and/or the Mississippi Department of Health regulations and state laws.


Jimmy Reese 0-668
Signature of Licensed Driller and License No.

2-14-02
Date

Additional Information Required On Back

If well telescopes please sketch and show depths.

GROUND LEVEL

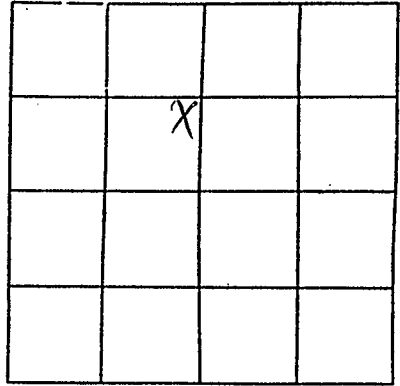

SECTION 27

Please indicate well location X.

Pump Capacity (GPM) <u>10</u>	No. of Stages <u>8</u>	Setting Depth <u>100</u> FT.
----------------------------------	---------------------------	---------------------------------

PUMP TEST

Well yielded 60 GPM with
a drawdown of 0 ft.
after 1 hours of pumping

LOG DATA

TYPE OF LOG RUN (Circle One): No-Log Run,
 Electric, Gamma Ray, Density, Sonic, Neutron;
Other (Describe) _____

Name of Organization Running Log _____

GEOLOGIC DATA (Office Use Only)

Surface Elev.	Geologic Unit	Unit Thickness	Depth to Top
Subs. SWL	Date	Analysis	Aquifer Test

Driller's Remarks

If more than one screen,
show location of each on sketch.