




If well telescopes please sketch and show depths.

GROUND LEVEL

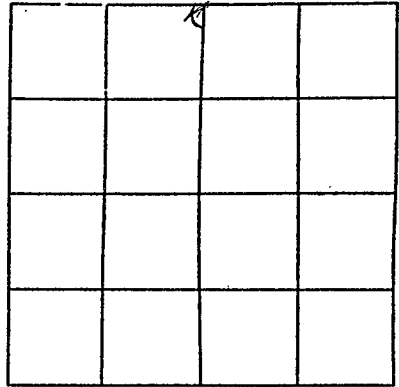

SECTION 5

Please indicate well location X.

Pump Capacity (GPM) <u>10</u>	No. of Stages <u>8</u>	Setting Depth <u>60</u> FT.
----------------------------------	---------------------------	--------------------------------

PUMP TEST

Well yielded 40 GPM with  
a drawdown of 0 ft.  
after 1 hours of pumping

LOG DATA

TYPE OF LOG RUN (Circle One): No Log Run,  
Electric, Gamma Ray, Density, Sonic, Neutron,  
Other (Describe) \_\_\_\_\_

Name of Organization Running Log \_\_\_\_\_

GEOLOGIC DATA (Office Use Only)

Surface Elev.	Geologic Unit	Unit Thickness	Depth to Top
Subs. SWL	Date	Analysis	Aquifer Test

Driller's Remarks

\_\_\_\_\_  
\_\_\_\_\_  
If more than one screen,  
show location of each on sketch.