

PIKE  
M  
6-27-66

Duplicate

MISSISSIPPI BOARD OF WATER COMMISSIONERS

WATER WELL DRILLERS LOG

Date: 6-27, 1966, Driller: W J Fitzgerald County Pike  
(When well drilled) (Name) (Where well is located)

(1) Owner of Land: MV DYkes  
(Name)  
McClomb Rt 2 -  
(Address)  
(2) Location: 1/4, 1/4, Sec 23 T 19 N  
5 miles of Progress  
(distance) (direction) (Nearest Town)  
(3) Topography: ✓  
(Hilly) (Flat) (Level)  
(4) Purpose of Well: Domestic  
(Domestic Irrigation  
Municipal, Industrial, Other)

Description & Color of Materials Sand, Clay, Red Clay, Shell, etc.	Thick- ness Feet	Depth Feet
<del>0 -</del>		
<u>Topsoil + Red Clay</u>	<u>0</u>	<u>0</u>
<u>Red Sand</u>	<u>20</u>	<u>60</u>
<u>Red Chalk</u>	<u>60</u>	<u>80</u>
<u>Hardy Soap Chalky</u>	<u>80</u>	<u>100</u>
<u>White Sand / Pebbles</u>	<u>100</u>	<u>170</u>

Information upon completion of well:

(1) Diameter 4 inches.  
(2) Total Depth 116 feet.  
(3) Water Level 80 feet below top of ground.  
(4) Cased to 108, Size 4 1/2  
(5) Screen: Size 4, Length 8  
(6) Were any formations sealed against pollution?  
\_\_\_\_\_ yes, ✓ no.

If YES depth of formation \_\_\_\_\_


Why \_\_\_\_\_

Drillers Remarks: \_\_\_\_\_

Yield in gpm: 109 PM

Size pump: 1 1/2 HP

Type power: Electric

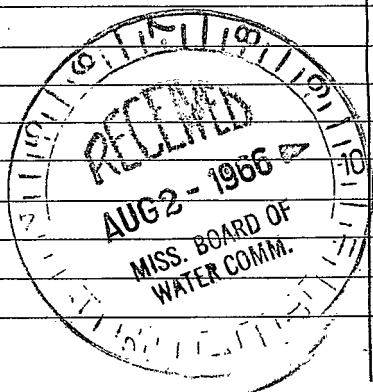

1

[Faint, illegible text, possibly bleed-through from the reverse side of the page]