

PIKE CODED

M1

MISSISSIPPI BOARD OF WATER COMMISSIONERS

2-18-66

WATER WELL DRILLERS LOG


Date: 2-18, 1966, Driller: Chester Reeves County Pike
(When well drilled) (Name) (Where well is located)

(1) Owner of Land:	Description & Color of Materials Sand, Clay, Red Clay, Shell, etc.	Thick- ness Feet	Depth Feet
Silva Springs Baptist Church (Name) RFD 1, Osyka (Address)	Red clay	15	15
(2) Location: 1/4, 1/4, Sec. 27 T1 R9	Yellow sand	75	60
4 miles south of Prayers (distance) (direction) (Nearest Town)	Red gravel & white sand	22	82
(3) Topography: Hilly (Hilly) (Flat) (Level)			
(4) Purpose of Well: Church (Domestic Irrigation Municipal, Industrial, Other)			

Information upon completion of well:

- (1) Diameter 4 inches.
- (2) Total Depth 82 feet.
- (3) Water Level 25 feet below top of ground.
- (4) Cased to Bottom, Size 4
- (5) Screen: Size 4, Length 6'
- (6) Were any formations sealed against pollution?
yes, no.

CODED

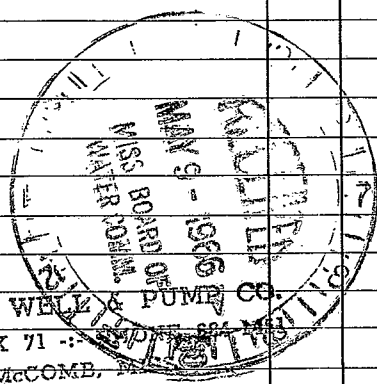

REEVES WELL & PUMP CO.
P. O. BOX 71 - JACKSON, MISSISSIPPI
McCOMB, MISSISSIPPI

If YES depth of formation _____

Why? _____

Drillers Remarks: adwell had

Yield in gpm: Est - 25

Size pump: 1/2 HP - 1 1/2"

Type power: Electric

