

**MISSISSIPPI
BOARD OF WATER COMMISSIONERS**
416 North State Street
Jackson, Mississippi 39201

WATER WELL DRILLERS LOG

6-25 1966 Fitzgerald W Service Pik
 date well completed firm name county well located

LANDOWNER: M. V. Dykes
R2 McComb Miss

description of formations encountered	from	to
	Top soil & Red clay	0
Red Sand	40	60
Red chalk	70	80
Sandy chalk	20	100
White sand gravel	20	120

(mailing address)


WELL LOCATION:
 sec 23 T 1 N 9 E
 S W
5 miles E of Progress
 (distance) (direction) (nearest town)

WELL PURPOSE: home
 (home, irrigation, municipal, industrial)

WELL COMPLETION DATA:


- (1) diameter (inches) 4
- (2) total depth (feet) 116
- (3) static water level (feet) 80 below above top of ground.
- (4) casing ~~108~~ 108
~~plastic~~ (material) (depth)
4 (size) if telescope see back.
- (5) screen 18 108
 (length) (depth to top)
4 (size) plastic (material)
- (6) pump 1-gal 8
 (HP) (yield gpm)
elec (type power)
- (7) electric log NO
 (yes or no)
 (organization running log)
- (8) how well bottom plugged Wood peg

DRILLERS REMARKS:

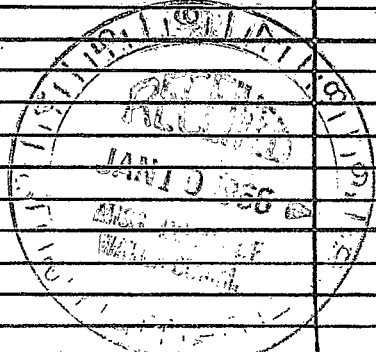

If well telescopes please sketch and show depths.

GROUND LEVEL

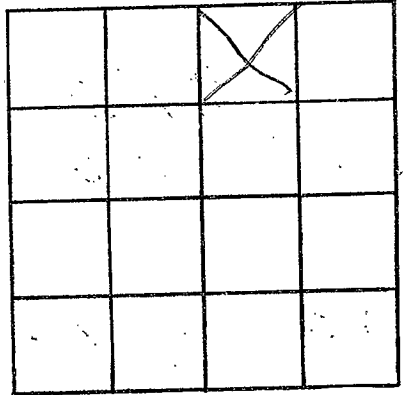

SECTION 23

Please indicate well location X.

ADDITIONAL INFORMATION

If more than one screen, show locations of each on sketch.