

Pike CODED
M3
8-67

MISSISSIPPI
 BOARD OF WATER COMMISSIONERS
 416 North State Street
 Jackson, Mississippi 39201

WATER WELL DRILLERS LOG

Aug-24 1967 Felgus well service Pike
 date well completed firm name county well located

LANDOWNER: Mable Tate

description of formations encountered	from to	
	feet	feet
<u>Red Clay</u>	<u>0</u>	<u>25</u>
<u>Red sand</u>	<u>25</u>	<u>50</u>
<u>Red gravel</u>	<u>50</u>	<u>65</u>
<u>Red coarse sand gravel</u>	<u>65</u>	<u>88</u>


Rt 4 Magnolia Miss
 (mailing address)

WELL LOCATION:
 sec. 30 T. 9 N. R. 9 E.
 S. W.
1.2 miles SE of Magnolia
 (distance) (direction) (nearest town)

WELL PURPOSE: Home
 (home, irrigation, municipal, industrial)

- WELL COMPLETION DATA:
- diameter (inches) 4
 - total depth (feet) 88
 - static water level (feet) 65 below top of ground.
 - casing Pneumatic, 82' (material) (depth)
4" if telescope see back. (size)
 - screen 6', 82' (length) (depth to top)
4", plastic (size) (material)
 - pump ?, ? (HP) (yield gpm)
Electric (type power)
 - electric log No (yes or no)
(organization running log)
 - how well bottom plugged would plug


CODED

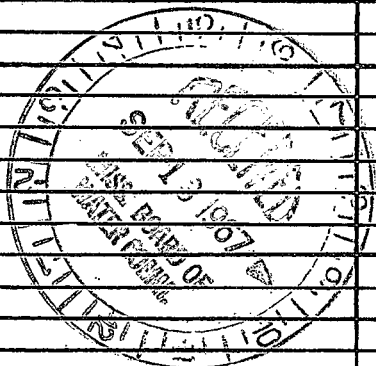

DRILLERS REMARKS:

If well telescopes please sketch and show depths.

GROUND LEVEL

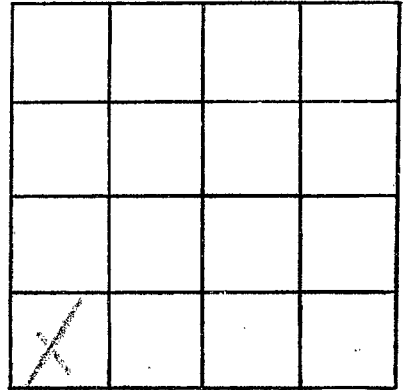

SECTION 3

Please indicate well location X.

ADDITIONAL INFORMATION

If more than one screen,
show locations of each on sketch.