

CODED

MISSISSIPPI BOARD OF WATER COMMISSIONERS
416 North State Street
Jackson, Mississippi 39201

Pike
M4
9-67

WATER WELL DRILLERS LOG

Sept 5 1967 Fitzgerald Water Well Pike
date well completed firm name county well located

LANDOWNER: Kennith Sterling

description of formations encountered from to

Manolia Rt

Top Soil / Red Clay 0 20
Red Sand 20 70
Gravel 70 104
Red Chalk 104 108
Gravel / Sand 108 120

(mailing address)

WELL LOCATION:

sec. 8 T. 1 N. 9 E. ✓
S. W. R. 9 W.
12 miles E of Manolia
(distance) (direction) (nearest town)

WELL PURPOSE: home
(home, irrigation, municipal, industrial)

WELL COMPLETION DATA:


- (1) diameter (inches) 4
- (2) total depth (feet) 120
- (3) static water level (feet) 95 -below- above top of ground.
- (4) casing plastic 1 1/4
(material) (depth)
4 If telescope see back.
(size)
- (5) screen 6' 1 1/4
(length) (depth to top)
4 plastic
(size) (material)
- (6) pump 1 1/2 7
(HP) (yield gpm)
Es
(type power)
- (7) electric log NO
(yes or no)

CODED

(organization funding log)


(8) how well bottom plugged Wood Peg

DRILLERS REMARKS:

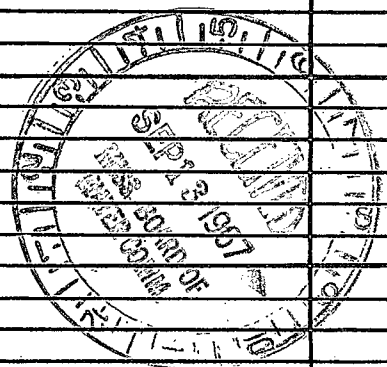

If well telescopes please sketch and show depths.

GROUND LEVEL

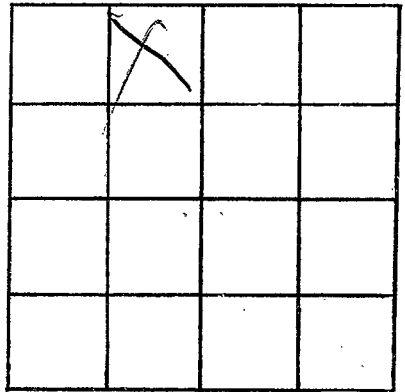

SECTION 2

Please indicate well location X.

ADDITIONAL INFORMATION

Lined area for additional information.

If more than one screen, show locations of each on sketch.