

**MISSISSIPPI
BOARD OF WATER COMMISSIONERS**
416 North State Street
Jackson, Mississippi 39201

WATER WELL DRILLERS LOG

Pike
M 3 CODED
9-67

Sept 9 67 *Reverend Drilling* *Pike*
date well completed firm name county well located

LANDOWNER *Chas. T. Lewis*
FD 4
Magnolia
(mailing address)

description of formations encountered	from	to
<i>Red clay</i>	<i>0</i>	<i>18</i>
<i>Red sand</i>	<i>18</i>	<i>65</i>
<i>Mixed sand, clay</i>		
<i>and gravel</i>	<i>65</i>	<i>110</i>
<i>Coarse sand and small gravel</i>	<i>110</i>	<i>121</i>

WELL LOCATION:
sec *7* T *1* N R *9* E
9 miles *SE* *Magnolia*
(distance) (direction) (nearest town)

WELL PURPOSE: *Home*
(home, irrigation, municipal, industrial)

WELL COMPLETION DATA:
(1) diameter (inches) *4"*
(2) total depth (feet) *121*
(3) static water level (feet) *42* below above top of ground
(4) casing *Plastic Bottom*
(material) (depth)

_____ If telescope see back.
(size)
(5) screen *6'* *115'*
(length) (depth to top)
4" *Plastic*
(size) (material)

(6) pump *1/2* *12*
(HP) (yield gpm)
Direct
(type power)

(7) electric log *NO*
(yes or no)

(organization running log)

(8) how well bottom plugged
completely


DRILLERS REMARKS:

CODED



If well telescopes please sketch and show depths.

GROUND LEVEL

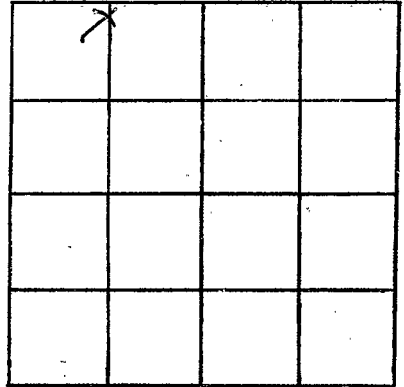

SECTION 7

Please indicate well location X.

ADDITIONAL INFORMATION

If more than one screen,
show locations of each on sketch.