

MISSISSIPPI
BOARD OF WATER COMMISSIONERS
416 North State Street
Jackson, Mississippi 39201

WATER WELL DRILLERS LOG

Nov. 1 1967 date well completed *Reverend King Co.* county well located *Pike*

LANDOWNER *Ewell*
Brynnfield
RFD, Magnolia
(mailing address)

WELL LOCATION:
sec. 5 T. 1 N. R. 9 E.
10 miles SE of Magnolia
(distance) (direction) (nearest town)

WELL PURPOSE: *Home*
(home, irrigation, municipal, industrial)

WELL COMPLETION DATA:

- (1) diameter (inches) 4"
(2) total depth (feet) 96
(3) static water level (feet) 48 below
top of ground.
(4) casing Plastic, bottom
(material) (depth)
if telescope see back.
(size)
(5) screen 6' 36'
(length) (depth to top)
4" Plastic
(size) (material)
(6) pump 1/2 HP 10
(type power) (yield gpm)
Elect.
(7) electric log no
(yes or no)

(organization running log)

(8) how well bottom plugged wooden plug

DRILLERS REMARKS:

description of formations
encountered

from to


led clay	0	15
sand & gravel	15	25
Red sand & clay	25	65
big gravel	65	70
fine cherty sand	70	85
coarse sand & gravel	85	92

CODED



If well telescopes please
sketch and show depths.

GROUND LEVEL

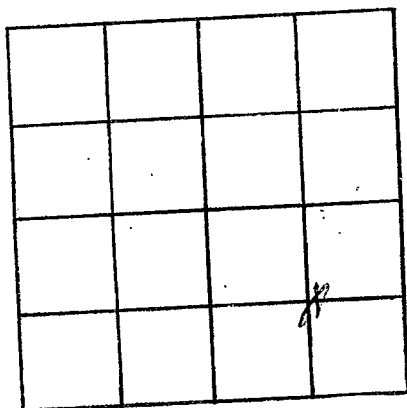

SECTION 5

Please indicate well location X.

ADDITIONAL INFORMATION

If more than one screen,
show locations of each on sketch.