

PIKE

MICRODEP

4-68

MISSISSIPPI BOARD OF WATER COMMISSIONERS
416 North State Street
Jackson, Mississippi 39201

WATER WELL DRILLERS LOG

April 19 1968 Fitzgerald well Inc Pike
date well completed firm name county well located

LANDOWNER: Eddie Jones

description of formations encountered from to

RR, Magnolia, Miss
(mailing address)

bed clay 0 22
bed sand 22 70
coarse sand & gravel 70 95

WELL LOCATION:

sec. 15 T-1 N R-9 E
10 miles E of Magnolia
(distance) (direction) (nearest town)

WELL PURPOSE: Home
(home, irrigation, municipal, industrial)

WELL COMPLETION DATA:

- (1) diameter (inches) 4"
- (2) total depth (feet) 95'
- (3) static water level (feet) 75 below top of ground.
- (4) casing Plastic 89'
(material) (depth)
4" if telescope see back.
(size)
- (5) screen 6' 89'
(length) (depth to top)
4" Plastic
(size) (material)
- (6) pump 7 7
(HP) (yield gpm)
7
(type power)
- (7) electric log No
(yes or no)
(organization running log)
- (8) how well bottom plugged usual per

CODED


APR 26 1968

DRILLERS REMARKS:

MISS. Bd. OF WATER COMM.

If well telescopes please sketch and show depths.

GROUND LEVEL

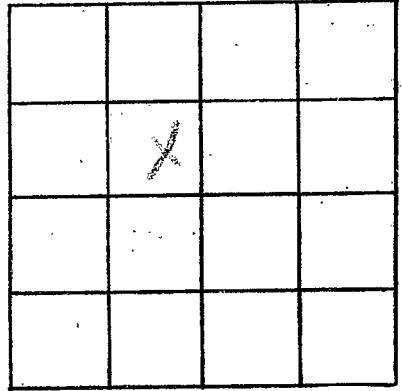

SECTION 15

Please indicate well location X.

ADDITIONAL INFORMATION

If more than one screen, show locations of each on sketch.