

PIKE
M11
4-68

CODED

MISSISSIPPI
BOARD OF WATER COMMISSIONERS
416 North State Street
Jackson, Mississippi 39201

WATER WELL DRILLERS LOG

April 11 1968 *Fitzgerald Well Ser* *Pike*
date well completed firm name county well located

LANDOWNER: *James Williams*

description of formations encountered	from	to
---------------------------------------	------	----

RR. Magnolia Miss -
(mailing address)

<i>bed clay</i>	0	30
<i>bed sand</i>	30	70
<i>bed gravel</i>	70	90
<i>bed shale</i>	90	110
<i>Coarse sand & gravel</i>	110	127

WELL LOCATION:
sec. 15 T 1 N R 9 E
10 miles E of Magnolia
(distance) (direction) (nearest town)

WELL PURPOSE: None
(home, irrigation, municipal, industrial)

WELL COMPLETION DATA:

- (1) diameter (inches) 4"
- (2) total depth (feet) 127'
- (3) static water level (feet) 100 below above top of ground.
- (4) casing Plastic 121'
(material) (depth)
4"
(size) if telescope see back.
- (5) screen 6' 121'
(length) (depth to top)
4" Plastic
(size) (material)
- (6) pump 1/2 12
(HP) (yield gpm)
Elco
(type power)
- (7) electric log No
(yes or no)

CODED

(organization running log)

(8) how well bottom plugged wool


DRILLERS REMARKS:

APR 26 1968

MISS. BD.
WATER

If well telescopes please sketch and show depths.

GROUND LEVEL

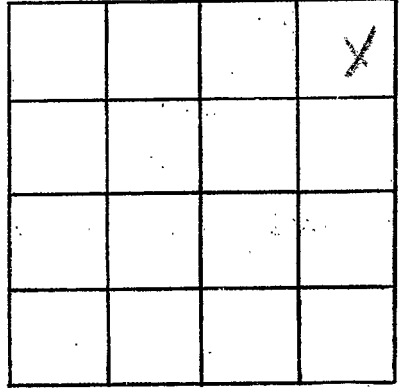

SECTION 15

Please indicate well location X.

ADDITIONAL INFORMATION

If more than one screen, show locations of each on sketch.