

PIKE **CODED**
 M12
 4-68

MISSISSIPPI
 BOARD OF WATER COMMISSIONERS
 416 North State Street
 Jackson, Mississippi 39201

WATER WELL DRILLERS LOG

April 1 1968 B. Fitzgerald & Son Pike
 (date well completed) (firm name) (county well located)

LANDOWNER: E. S. Alfred

description of formations encountered from to

RR. Magnolia, Miss.
 (mailing address)

0-30 Red clay	0	30
Red sand	30	75
Coarse sand & gravel	75	90

WELL LOCATION:
 sec 20 T 1 N R 9 E
 2 miles 5 of Progress
 (distance) (direction) (nearest town)

WELL PURPOSE: Home
 (home, irrigation, municipal, industrial)

WELL COMPLETION DATA:

- (1) diameter (inches) 4
- (2) total depth (feet) 90
- (3) static water level (feet) 65 below top of ground.
- (4) casing Plastic, 84' (material), (depth)
 4" (size) if telescope see back.
- (5) screen 6' (length), 84' (depth to top)
 4" (size), Plastic (material)
- (6) pump 2 (HP), 3 (yield gpm)
 Elec (type power)
- (7) electric log 70 (yes or no)

CODED

APR 26 1968

MISS. BD. OF WATER COMM.


(organization running log)

DRILLERS REMARKS:

how well bottom plugged braced

If well telescopes please sketch and show depths.

GROUND LEVEL

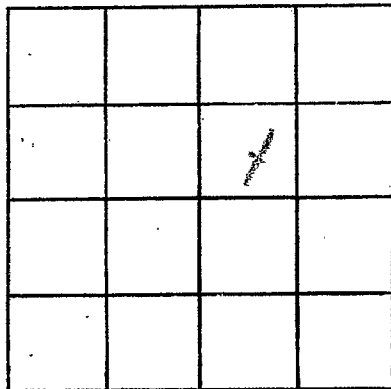

SECTION 70

Please indicate well location X.

ADDITIONAL INFORMATION

If more than one screen, show locations of each on sketch.