

CODED

MISSISSIPPI BOARD OF WATER COMMISSIONERS
416 North State Street
Jackson, Mississippi 39201

WATER WELL DRILLERS LOG

PIKE
M 14
8-68

8-19 1968 Fitzgerald Water Well Pike
date well completed firm name county well located

LANDOWNER: L. MON ESTUS
Rt Magnolia Miss

description of formations encountered	from	to
top soil & Red Clay	0	20
Band	20	75
Gravel & sand	75	85
Chalk	85	100
Gravel & sand	100	115
Soupy sand	115	140
(Coarse sand & gravel)	140	155

(mailing address)


WELL LOCATION:
sec 2 T 1 N 9 E
10 miles SW of Tylertown
(distance) (direction) (nearest town)

WELL PURPOSE: home
(home, irrigation, municipal, industrial)

WELL COMPLETION DATA:

- (1) diameter (inches) 4
- (2) total depth (feet) 154
- (3) static water level (feet) 80 below above top of ground.
- (4) casing plastic 148
(material) (depth)
4 if telescope see back.
(size)
- (5) screen 6' 148
(length) (depth to top)
4 Sch 40
(size) (material)
- (6) pump 1/2 Sub 12901
(HP) (yield/gpm)
Elec 230
(type power)
- (7) electric log NO
(yes or no)
- (organization running log)
- (8) how well bottom plugged Wood peg


CODED

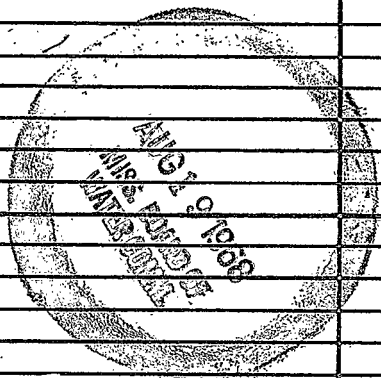

DRILLERS REMARKS:

If well telescopes please sketch and show depths.

GROUND LEVEL

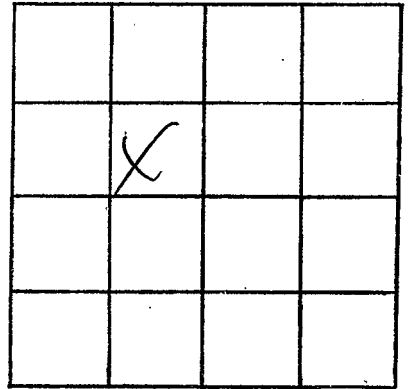

SECTION 2

Please indicate well location X.

ADDITIONAL INFORMATION

If more than one screen, show locations of each on sketch.