

Pike CODE
 MIS.
 9-18-68

MISSISSIPPI
 BOARD OF WATER COMMISSIONERS
 416 North State Street
 Jackson, Mississippi 39201

CODED

WATER WELL DRILLERS LOG

Sept 18 1968 Reenes well Okumpa. Pike
 date well completed firm name county well located

LANDOWNER: Allan Smith

description of formations encountered	from	to
Red clay	0	18
Red chert	18	46
Small gravel sand	46	62
chert & gravel	62	76
Red gravel sand	76	83

RFD 1, Osyka -
 (mailing address)

WELL LOCATION:
 sec 34 T 1 N R 9 E
 4 miles SE Poplar (distance) (direction) (nearest town)


WELL PURPOSE: Home
 (home, irrigation, municipal, industrial)

- WELL COMPLETION DATA:
- (1) diameter (inches) 4"
 - (2) total depth (feet) 83
 - (3) static water level (feet) 50 below top of ground
 - (4) casing Plastic bottom (material) (depth)
 - (size) if telescope see back.
 - (5) screen 6' 77 (length) (depth to top)
 4" Plastic (size) (material)
 - (6) pump screw drive (type) (yield gpm)
 elect (type power)
 - (7) electric log NO (yes or no)

(organization running log)


(8) how well bottom plugged
 wood plug

DRILLERS REMARKS:
 old well not good

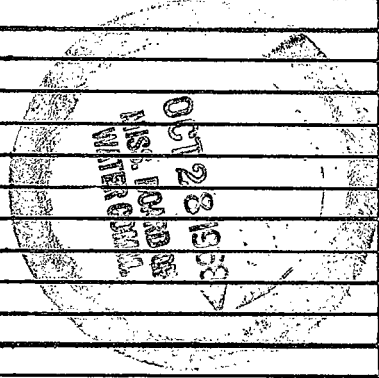

If well telescopes please sketch and show depths.

GROUND LEVEL

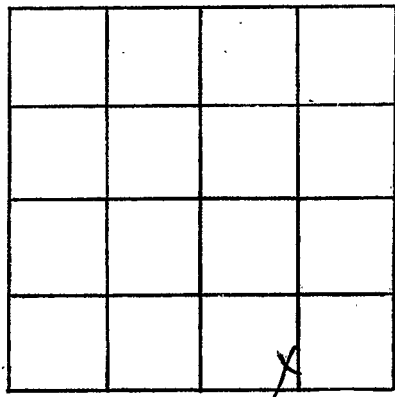

SECTION 54

Please indicate well location X.

ADDITIONAL INFORMATION

Lined area for additional information.

If more than one screen, show locations of each on sketch.