

CODED

Oike  
M16  
9-5-68

MISSISSIPPI  
BOARD OF WATER COMMISSIONERS  
416 North State Street  
Jackson, Mississippi 39201

WATER WELL DRILLERS LOG

Sept 5 1968 Keenes well pumps Co. Pike  
date well completed firm name county well located


LANDOWNER: Guy  
Foster Hwy. S.  
Rt-1, Osyka  
(mailing address)

| description of fomations encountered | from | to |
|--------------------------------------|------|----|
| yellow chalk clay                    | 0    | 18 |
| Small gravel sand                    | 18   | 35 |
| Red chert to chalk                   | 35   | 60 |
| Red gravel sand                      | 60   | 68 |

WELL LOCATION:  
sec. 27 T. 1 N. R. 9 E  
3 miles SE Popper  
(distance) (direction) (nearest town)

WELL PURPOSE: Home  
(home, irrigation, municipal, industrial)


- WELL COMPLETION DATA:
- (1) diameter (inches) 4"
  - (2) total depth (feet) 68
  - (3) static water level (feet) 73 below top of ground.
  - (4) casing Plastic ballam (material) (depth)
  - (5) screen 6' 62 (length) (depth to top)  
4" Plastic (size) (material)
  - (6) pump 1/2 HP 12 (type power) (yield gpm)
  - (7) electric log No (yes or no)
  - (8) how well bottom plugged wooden plug

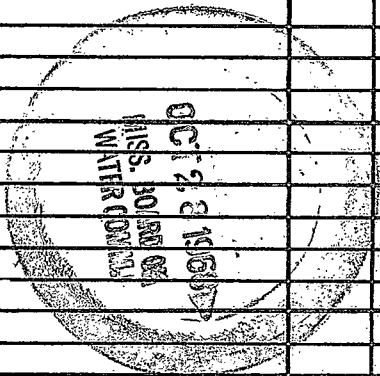

DRILLERS REMARKS: New House.

If well telescopes please sketch and show depths.

GROUND LEVEL

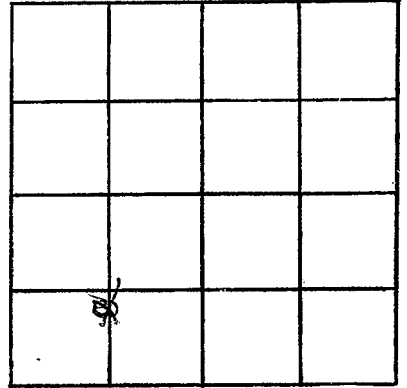

SECTION 21

Please indicate well location X.

ADDITIONAL INFORMATION

If more than one screen, show locations of each on sketch.