

CODED

MISSISSIPPI
BOARD OF WATER COMMISSIONERS
416 North State Street
Jackson, Mississippi 39201

WATER WELL DRILLERS LOG

PIKE
M18
9-68

Sept 18 1968 Dr. T. Cavington Pike
date well completed firm name county well located

LANDOWNER: Frank Perzoff

description of fomations encountered from to

Progress, Miss
(mailing address)

2 1/2 ft 0 20
SAND & GRAVELS 20 105

WELL LOCATION:
sec. 21 T1 N 9 E
3 miles SE of Progress
(distance) (direction) (nearest town)

WELL PURPOSE: Home
(home, irrigation, municipal, industrial)

WELL COMPLETION DATA:

(1) diameter (inches) 4"

(2) total depth (feet) 105'

(3) static water level (feet) 40' below above top of ground.

(4) casing Alastic 99'
(material) (depth)

_____ if telescope see back.
(size)

(5) screen 6' 99'
(length) (depth to top)

4" Plastic
(size) (material)

(6) pump 1/2 9
(HP) (yield gpm)


A.C.
(type power)

(7) electric log _____
(yes or no)

_____ (organization running log)


(8) how well bottom plugged Wood

DRILLERS REMARKS:

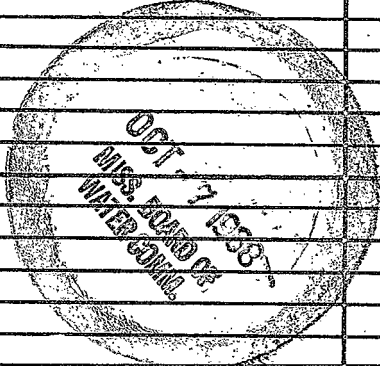

If well telescopes please sketch and show depths.

GROUND LEVEL

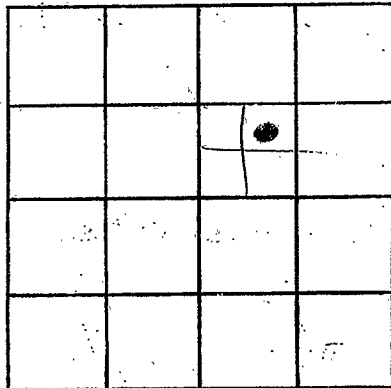

SECTION

~~21~~ 21?

Please indicate well location X.

ADDITIONAL INFORMATION

If more than one screen, show locations of each on sketch.