

CODED

CODED

MISSISSIPPI
 BOARD OF WATER COMMISSIONERS
 416 North State Street
 Jackson, Mississippi 39201

WATER WELL DRILLERS LOG

Aug 16 19 68 *Keeverwell Pump* *Pike*
 date well completed firm name county well located


LANDOWNER: *Sally Schilling*
RT-1, Osyka.
 (mailing address)

description of formations encountered	from	to
<i>red clay</i>	<i>0</i>	<i>18</i>
<i>red sand & gravel</i>	<i>18</i>	<i>90</i>
<i>gravel</i>	<i>90</i>	<i>98</i>
<i>red chalk</i>	<i>98</i>	<i>105</i>
<i>sand & gravel</i>	<i>105</i>	<i>114</i>

WELL LOCATION:
 sec *35* T *1* N R *9* E
11 miles *East* of *Osyka*
 (distance) (direction) of (nearest town)

WELL PURPOSE: *Farm*
 (home, irrigation, municipal, industrial)

- WELL COMPLETION DATA:
- (1) diameter (inches) *4"*
 - (2) total depth (feet) *114*
 - (3) static water level (feet) *90* below above top of ground.
 - (4) casing *plastic ballast*
 (material) (depth)
 - (size) If telescope see back.
 - (5) screen *6'* *108*
 (length) (depth to top)
 - 4"* *plastic*
 (size) (material)
 - (6) pump *old Red Pump*
 (HP) (yield gpm)
 - (type power)
 - (7) electric log *dest.*
 (yes or no)

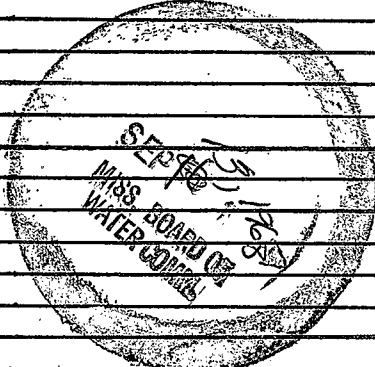


(organization running log)

(8) how well bottom plugged *wooden plug*

DRILLERS REMARKS: *old well bad*

If well telescopes please sketch and show depths.

GROUND LEVEL

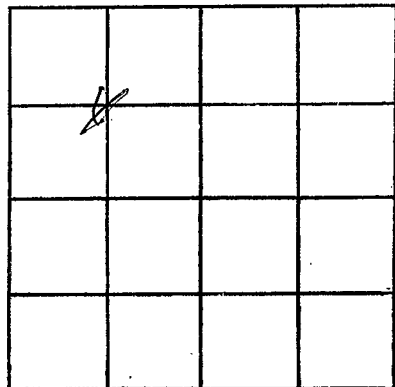

SECTION 35

Please indicate well location X.

ADDITIONAL INFORMATION

If more than one screen,
show locations of each on sketch.