

PIKE

M20 <sup>INDEXED</sup>

MISSISSIPPI BOARD OF WATER COMMISSIONERS

2-25-66

CODED

# WATER WELL DRILLERS LOG

Date: 2-25, 1966, Driller: Chester Reeves County Pike  
 (When well drilled) (Name) (Where well is located)

		Description & Color of Materials Sand, Clay, Red Clay, Shell, etc.	Thick- ness Feet	Depth Feet
(1) Owner of Land: <u>Rayton Henry Jr.</u> (Name) <u>RD 1, Osyka.</u> (Address)		<u>Red Clay</u>	<u>20</u>	<u>20</u>
(2) Location: <u>1/4</u> , <u>1/4</u> , Sec <u>17-9</u> <u>2</u> miles <u>S.W.</u> of <u>Poppers</u> (distance) (direction) (Nearest Town)		<u>Red pinch</u> <u>chalk</u>	<u>35</u>	<u>55</u>
(3) Topography: <u>Hilly</u> (Hilly) (Flat) (Level)		<u>Yellow sand</u> <u>gravel</u>	<u>40</u>	<u>95</u>
(4) Purpose of Well: <u>Domestic</u> (Domestic Irrigation Municipal, Industrial, Other)		<u>white chalk</u> <u>coarse gravel</u> <u>sand</u>	<u>35</u>	<u>130</u>
			<u>16</u>	<u>146</u>

## Information upon completion of well:

- (1) Diameter 4 inches.
- (2) Total Depth 146 feet.
- (3) Water Level 75 feet below top of ground.
- (4) Cased to Bottom, Size 4'.
- (5) Screen: Size 4', Length 6'.
- (6) Were any formations sealed against pollution?  
 \_\_\_\_\_ yes, \_\_\_\_\_ no.

If YES depth of formation \_\_\_\_\_

Why \_\_\_\_\_


Drillers Remarks: well bad

Yield in gpm: 15

Size pump: 1/2 HP Sub

Type power: Electric

*Cannot locate  
well*

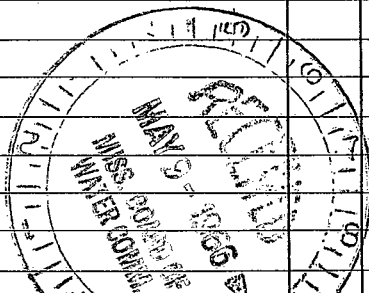

REEVES WELL & PUMP CO.  
 P. O. BOX 71 PHONE 884-1431  
 McCOMB, MISS.

Mail this copy to Board of Water Commissioners 429 Miss. St. Jackson, Miss.

1875