

Pike
M 21
10-9-68

MISSISSIPPI
 BOARD OF WATER COMMISSIONERS
 416 North State Street
 Jackson, Mississippi 39201

CODED

WATER WELL DRILLERS LOG

Pike
Franklin

10-9 1968 Fitzgerald firm name county well located

LANDOWNER: One Mrs. Dillon

description of formations encountered	from	to
<u>Red clay</u>	<u>0</u>	<u>20</u>
<u>Red sand</u>	<u>20</u>	<u>60</u>
<u>Red gravel</u>	<u>60</u>	<u>75</u>
<u>Fine sand</u>	<u>75</u>	<u>90</u>
<u>Coarse sand & gravel</u>	<u>90</u>	<u>112</u>
		<u>2'</u> <u>4'</u>

R.R. Magnum min.
 (boiling address)


WELL LOCATION:
 sec. 20 T. 1 N R. 9 E
S W
1/4 miles — of Progress
 (distance) (direction) (nearest town)

WELL PURPOSE: Home
 (home, irrigation, municipal, industrial)

WELL COMPLETION DATA:


- (1) diameter (inches) 4
- (2) total depth (feet) 112
- (3) static water level (feet) 80 below above top of ground.
- (4) casing Plastic 106, (material) (depth)
4 if telescope see back. (size)
- (5) screen 6, 106 (length) (depth to top)
4, plastic (size) (material)
- (6) pump ?, ? (HP) (yield gpm)
Elco (type power)
- (7) electric log no (yes or no)
— (organization running log)
- (8) how well bottom plugged wood plug

DRILLERS REMARKS:

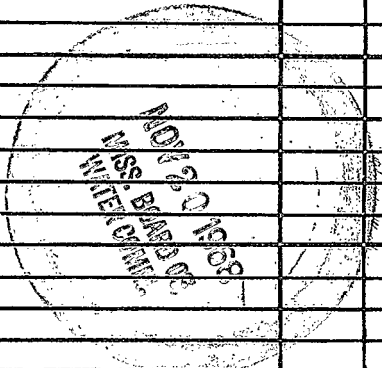

If well telescopes please sketch and show depths.

GROUND LEVEL

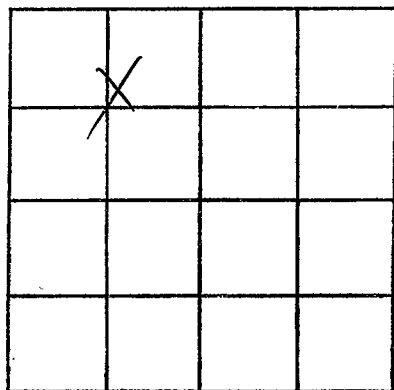

SECTION 20

Please indicate well location X.

ADDITIONAL INFORMATION

If more than one screen, show locations of each on sketch.