

BODED

Pike
M 22
12-5-68

MISSISSIPPI
BOARD OF WATER COMMISSIONERS
416 North State Street
Jackson, Mississippi 39201

CODED

WATER WELL DRILLERS LOG

Dec 5 1968 Fitzgerald well Pike
date well completed firm name county well located

LANDOWNER: John Hall
RT 2, McComb

(mailing address)

description of formations encountered	from	to
<u>Red clay</u>	<u>0</u>	<u>20</u>
<u>Red sand</u>	<u>20</u>	<u>30</u>
<u>Red gravel</u>	<u>30</u>	<u>90</u>
<u>Red shale</u>	<u>90</u>	<u>110</u>
<u>Orange sand & gravel</u>	<u>110</u>	<u>128</u>

WELL LOCATION:

sec. 2 T. N R. 9 E
4 1/2 miles NE of Prezious
(distance) (direction) (nearest town)

WELL PURPOSE:

Home
(home, irrigation, municipal, industrial)

WELL COMPLETION DATA:

- (1) diameter (inches) 4
- (2) total depth (feet) 128
- (3) static water level (feet) 90 below top of ground.
- (4) casing plastic, 122'
(material) (depth)
4 if telescope see back.
(size)
- (5) screen 6', 122'
(length) (depth to top)
4, plastic
(size) (material)
- (6) pump 1, 1
(HP) (yield gpm)
Chen
(type power)
- (7) electric log no
(yes or no)
- (organization running log)
- (8) how well bottom plugged compley

CODED


DEC 23 1968

MISSISSIPPI
BOARD OF WATER COMMISSIONERS

DRILLERS REMARKS:

If well telescopes please sketch and show depths.

GROUND LEVEL

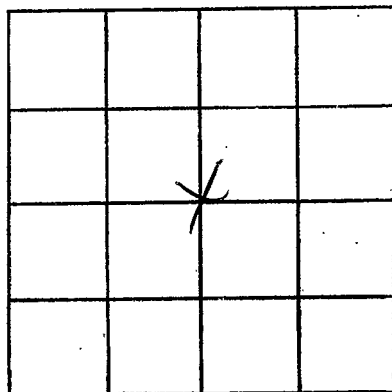

SECTION 2

Please indicate well location X.

ADDITIONAL INFORMATION

If more than one screen, show locations of each on sketch.