

DIKE  
M 24  
2-24-69

MISSISSIPPI  
BOARD OF WATER COMMISSIONERS  
416 North State Street  
Jackson, Mississippi 39201

WATER WELL DRILLERS LOG

Feb 24 1969 Fitzgerald Well Serv. Pin  
date well completed firm name county well located

CODED

LANDOWNER:  
Elmer Seidner  
R.R. Magnolia, Miss.  
(mailing address)  
WELL LOCATION:  
sec. 19 T 1 N R 9 E  
10 miles SE of Magnolia  
(distance) (direction) (nearest town)

| description of formations encountered | from       | to         |
|---------------------------------------|------------|------------|
| <u>Red clay</u>                       | <u>0</u>   | <u>20</u>  |
| <u>Red Sand</u>                       | <u>20</u>  | <u>80</u>  |
| <u>Red Sand &amp; gravel</u>          | <u>80</u>  | <u>135</u> |
| <u>Red Sand</u>                       | <u>135</u> | <u>142</u> |
| <u>Coarse Sand &amp; gravel</u>       | <u>142</u> | <u>151</u> |

WELL PURPOSE: Home  
(home, irrigation, municipal, industrial)


WELL COMPLETION DATA:  
(1) diameter (inches) 4"  
(2) total depth (feet) 155'  
(3) static water level (feet) 70 below above top of ground.  
(4) casing plastic 149  
(material) (depth)  
4 if telescope see back.  
(size)  
(5) screen 6 149  
(length) (depth to top)  
4 plastic  
(size) (material)  
(6) pump 1 6  
(HP) (yield gpm)  
9kw  
(type power)  
(7) electric log No  
(yes or no)  
(organization running log)  
(8) how well bottom plugged woolpey

DRILLERS REMARKS:

MAILED 7 5 1969  
MISS. DEPT. OF WATER CONTROL

If well telescopes please sketch and show depths.

GROUND LEVEL

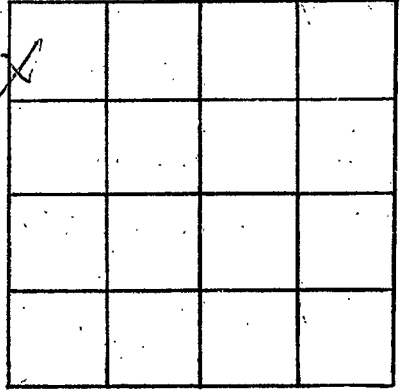

SECTION 19

Please indicate well location X.

ADDITIONAL INFORMATION

If more than one screen, show locations of each on sketch.