

Pike
M 26
4-21-70

MISSISSIPPI
BOARD OF WATER COMMISSIONERS
416 North State Street
Jackson, Mississippi 39201

CODED

WATER WELL DRILLERS LOG

Apr 21 1970 date well completed
Fitzgibbon Well Co firm name
Pike county well located

LANDOWNER:
Pentecost
R.R. Osypko, Miss.
(mailing address)

description of formations encountered	from	to
Red clay	0	20
Red sand	20	60
Coarse Red sand	60	90
Red gravel	90	115
Coarse sand & gravel	115	132

WELL LOCATION:
sec. 18 T 1 N R 9 E
3 miles W of Proctor
(distance) (direction) (nearest town)

WELL PURPOSE:
Home
(home, irrigation, municipal, industrial)

WELL COMPLETION DATA:
(1) diameter (inches) 4
(2) total depth (feet) 132
(3) static water level (feet) 90 below top of ground.
(4) casing Plaster 124 (material) (depth)
4 (size) if telescope see back.
(5) screen 8 124 (length) (depth to top)
4 Plaster (size) (material)
(6) pump 1 4 (HP) (yield gpm)
Electric (type power)
(7) electric log Yes (yes or no)
(organization running log)
(8) how well bottom plugged Good

CODED


APR 29 1970

MISS. BD. OF
WATER COMMI.

DRILLERS REMARKS:

If well telescopes please sketch and show depths.

GROUND LEVEL

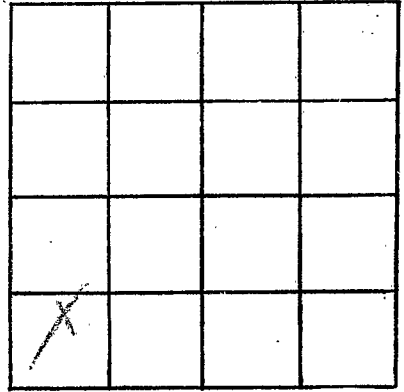

SECTION 18

Please indicate well location X.

ADDITIONAL INFORMATION

If more than one screen,
show locations of each on sketch.