

**MISSISSIPPI
BOARD OF WATER COMMISSIONERS**
416 North State Street
Jackson, Mississippi 39201

Pike
M 27
5-16-70
3 **BD**

WATER WELL DRILLERS LOG


16 May 1970 A. T. Co. met at Sen Pike
date well completed firm name county well located

| LANDOWNER: | description of formations encountered | from | to |
|--|---------------------------------------|-----------|------------|
| <u>Van Hant</u> | | | |
| <u>Progress, Miss.</u> (mailing address) | <u>Clay</u> | <u>0</u> | <u>20</u> |
| | <u>Red clay sand</u> | <u>20</u> | <u>40</u> |
| | <u>Clay</u> | <u>40</u> | <u>60</u> |
| | <u>Clay Sand</u> | <u>60</u> | <u>75</u> |
| | <u>Sand</u> | <u>75</u> | <u>125</u> |
| WELL LOCATION: sec. <u>7</u> T. <u>1</u> R. <u>9</u> <u>2</u> miles <u>West</u> of <u>Progress</u> (distance) (direction) (nearest town) | | | |
| WELL PURPOSE: <u>Hand</u> (home, irrigation, municipal, industrial) | | | |
| WELL COMPLETION DATA: | | | |
| (1) diameter (inches) <u>4</u> | | | |
| (2) total depth (feet) <u>125</u> | | | |
| (3) static water level (feet) <u>75</u> below top of ground. | | | |
| (4) casing <u>PI</u> <u>119</u> (material) (depth) | | | |
| (size) if telescope see back. | | | |
| (5) screen <u>6'</u> <u>119</u> (length) (depth to top) | | | |
| <u>4</u> <u>PI</u> (size) (material) | | | |
| (6) pump <u>8</u> <u>10</u> (HP) (yield gpm) | | | |
| <u>Electric</u> (type power) | | | |
| (7) electric log (yes or no) | | | |
| (organization running log) | | | |
| (8) how well bottom plugged <u>wood</u> | | | |
| DRILLERS REMARKS: | | | |

JUN 5 1970

If well telescopes please sketch and show depths.

GROUND LEVEL

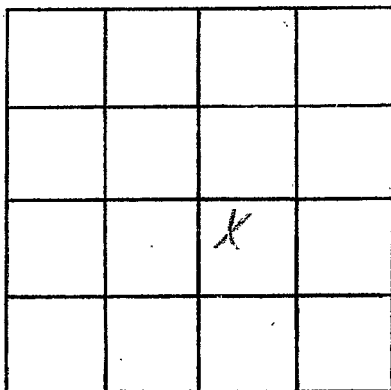

SECTION 7

Please indicate well location X.

ADDITIONAL INFORMATION

If more than one screen,
show locations of each on sketch.