

Pike
M 28
6-26-70

MISSISSIPPI
BOARD OF WATER COMMISSIONERS
416 North State Street
Jackson, Mississippi 39201

CODED

WATER WELL DRILLERS LOG

June 26, 1970 Chester Keene Pike
date well completed firm name county well located

LANDOWNER	description of formations encountered	from	to
fahrukh... RFB Magnolia (mailing address)	clay	0	10
	sand & gravel	10	80
	gravel & light chalk	80	92
	small gravel	92	107

WELL LOCATION:

sec. 7 T. 1 N R. 9 E
2 miles N of New Rivers (distance) (direction) (nearest town)

WELL PURPOSE: Hog Farm (home, irrigation, municipal, industrial)

WELL COMPLETION DATA:

- (1) diameter (inches) 4"
- (2) total depth (feet) 107
- (3) static water level (feet) 69 below top of ground.
- (4) casing Plastic Ballast (material) (depth)
- (size) If telescope see back.
- (5) screen 6" 101 (length) (depth to top)
- 4" Plastic (size) (material)
- (6) pump 3/4 HP 15 (HP) (yield gpm)
- split (type power)
- (7) electric log NO (yes or no)
- (organization running log)

CODED


(8) how well bottom plugged
wood chips

DRILLERS REMARKS:
New location

III 27 1970

If well telescopes please sketch and show depths.

GROUND LEVEL

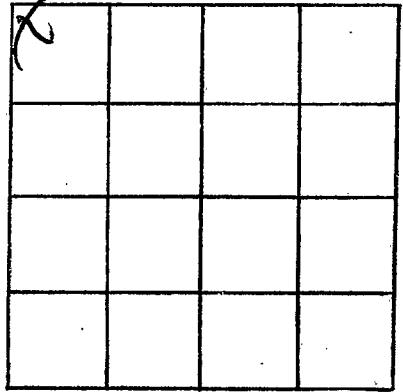

SECTION 2

Please indicate well location X.

ADDITIONAL INFORMATION

If more than one screen,
show locations of each on sketch.