

PIKE
M29
9-18-70

MISSISSIPPI
BOARD OF WATER COMMISSIONERS
416 North State Street
Jackson, Mississippi 39201

CODED

WATER WELL DRILLERS LOG

9-18 1970 Edgewood Dr Pike
date well completed firm name county well located

LANDOWNER:
Alton Smith
H.R. Osyka
(mailing address)

description of formations encountered	from	to
<u>Red clay</u>	<u>0</u>	<u>30</u>
<u>Red sand</u>	<u>30</u>	<u>90</u>
<u>Red clay</u>	<u>90</u>	<u>115</u>
<u>Coarse sand</u>	<u>115</u>	<u>125</u>

WELL LOCATION:
sec. 31 T. 1 N. R. 9 E
10 miles E of OSYKA
(distance) (direction) (nearest town)

WELL PURPOSE: Home
(home, irrigation, municipal, industrial)

- WELL COMPLETION DATA:
- (1) diameter (inches) 4
 - (2) total depth (feet) 120
 - (3) static water level (feet) 20 below top of ground.
 - (4) casing plastic, 119
(material) (depth)
4 if telescope see back.
(size)
 - (5) screen 8, 117
(length) (depth to top)
4 (size) plastic (material)
 - (6) pump 1 7
(HP) (yield gpm)
elec (type power)
 - (7) electric log no
(yes or no)
(organization running log)
 - (8) how well bottom plugged wood plug

CODED


OCT 16 1970

MISS. BD. OF
WATER COMMISSIONERS

DRILLERS REMARKS:

If well telescopes please sketch and show depths.

GROUND LEVEL

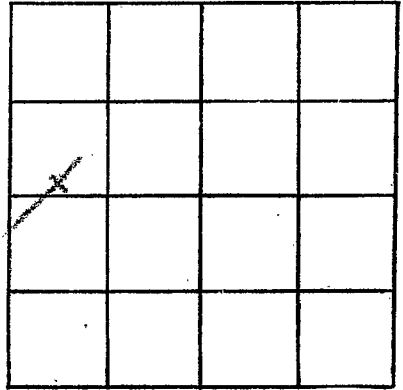

SECTION 31

Please indicate well location X.

ADDITIONAL INFORMATION

If more than one screen,
show locations of each on sketch.