

PIKE

M 30

9-17-70

MISSISSIPPI BOARD OF WATER COMMISSIONERS
416 North State Street
Jackson, Mississippi 39201

CODED

WATER WELL DRILLERS LOG

Sept 17 70 Chester Kelner Pike
date well completed firm name county well located

LANDOWNER: Miss Taylor Johnson
H-1, Osyka, Miss
(mailing address)

description of formations encountered	from	to
Red clay	0	18
Red cherty sand	18	57
Chalk & gravel	57	109
Blue pink sand	109	117
Coarse sand & red gravel	117	127

WELL LOCATION:
sec 22 T 1 N R 9 E
11 miles ENE of Osyka
(distance) (direction) (nearest town)

WELL PURPOSE: Home
(home, irrigation, municipal, industrial)

- WELL COMPLETION DATA:
- (1) diameter (inches) 4"
 - (2) total depth (feet) 127
 - (3) static water level (feet) 100 below top of ground.
 - (4) casing Plastic (material) bottom (depth)
 - (5) screen 6' (length) 127' (depth to top)
4" (size) Plastic (material)
 - (6) pump Sub-12 (HP) 12 (yield gpm)
Rect (type power)
 - (7) electric log No (yes or no)
- (organization running log)

CODED


(8) how well bottom plugged?
well plugged

DRILLERS REMARKS:
2 1/2" well bore

NOV 16 1970

If well telescopes please sketch and show depths.

GROUND LEVEL

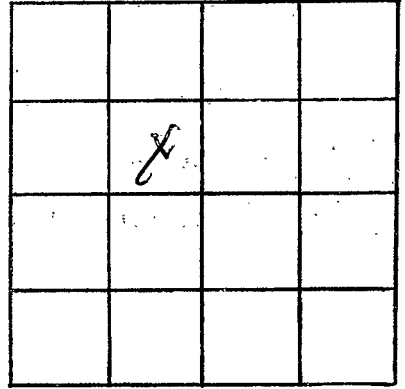

SECTION 29

Please indicate well location X.

ADDITIONAL INFORMATION

If more than one screen,
show locations of each on sketch.