

PIKE  
M 32  
10-2-70

MISSISSIPPI  
BOARD OF WATER COMMISSIONERS  
416 North State Street  
Jackson, Mississippi 39201

**CODED**

WATER WELL DRILLERS LOG

oct 20 1970 date well completed  
Chester Keefer firm name  
Pike county well located

LANDOWNER:

Marvin Schilling  
H-1, Oryba  
(mailing address)

description of formations encountered

from to

WELL LOCATION:

sec. 35 T 1 N R 9 E  
12 miles E of Oryba  
(distance) (direction) (nearest town)

WELL PURPOSE: Home - Dairy  
(home, irrigation, municipal, industrial)

WELL COMPLETION DATA:

- (1) diameter (inches) 4"
- (2) total depth (feet) 127
- (3) static water level (feet) 90 below top of ground
- (4) casing Waste Bottom  
(material) (depth)
- (5) screen 6' 171'  
(length) (depth to top)  
4" Plastic  
(size) (material)
- (6) pump 3/4 HP 15  
(HP) (yield gpm)  
Electric  
(type power)
- (7) electric log no  
(yes or no)

(organization running log)

(8) how well bottom plugged  
wooden plug

DRILLERS REMARKS:

all good pump  
well bed

description of formations encountered	from	to
clay	0	10
sand	10	60
chalk	60	85
sand	85	100
chalk	100	110
sand & gravel	110	127


**CODED**

NOV 16 1970

MISS. Bd. of  
WATER COMMISSIONERS

If well telescopes please sketch and show depths.

GROUND LEVEL

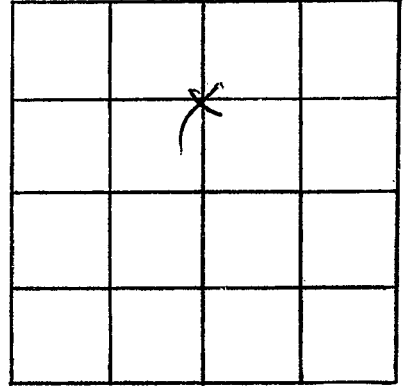

SECTION 35

Please indicate well location X.

ADDITIONAL INFORMATION

If more than one screen,  
show locations of each on sketch.