

PIKE
M34
12-7-70

MISSISSIPPI
BOARD OF WATER COMMISSIONERS
416 North State Street
Jackson, Mississippi 39201

CODED

WATER WELL DRILLERS LOG

12-7 1970 F. G. Gumbert well Ltd Pike
date well completed firm name county well located

LANDOWNER: Pierre Mayer
P.R. Magnolia
(mailing address)

description of formations encountered	from	to
<u>Red clay</u>	<u>0</u>	<u>20</u>
<u>Red sand</u>	<u>20</u>	<u>80</u>
<u>Coarse sand & gravel</u>	<u>80</u>	<u>118</u>

WELL LOCATION:
sec. 18 T 1 N R 9 E
S W
2 miles NW of Progress
(distance) (direction) (nearest town)

WELL PURPOSE: None
(home, irrigation, municipal, industrial)

WELL COMPLETION DATA:

(1) diameter (inches) 4

(2) total depth (feet) 118

(3) static water level (feet) 90 below above top of ground.

(4) casing Plastic 110
(material) (depth)
4 If telescope see back.
(size)

(5) screen 8 110
(length) (depth to top)
4 Plastic
(size) (material)

(6) pump 1 6
(HP) (yield gpm)
60
(type power)

(7) electric log no
(yes or no)

(organization running log)

CODED

(8) how well bottom plugged Goodly


DEC 17 1970

DRILLERS REMARKS:

MISSISSIPPI
BOARD OF WATER COMMISSIONERS
JACKSON, MISSISSIPPI

If well telescopes please sketch and show depths.

GROUND LEVEL

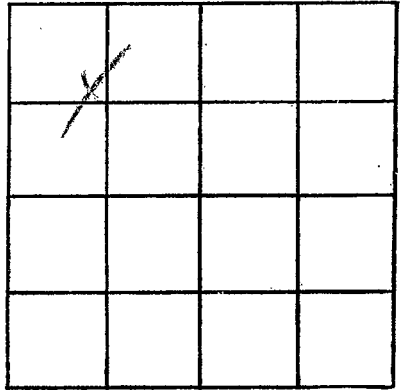

SECTION 13

Please indicate well location X.

ADDITIONAL INFORMATION

If more than one screen, show locations of each on sketch.