

MISSISSIPPI
BOARD OF WATER COMMISSIONERS
416 North State Street
Jackson, Mississippi 39201

CODED

WATER WELL DRILLERS LOG

PIKE
M 35
12-3-70

Dec 3 1970 *Chesters* *Pike*
date well completed firm name county well located

LANDOWNER: *James George*
RFD, Magnolia
(mailing address)

WELL LOCATION:
sec. *4* T. *1* N. R. *9* E
3 miles *NE* of *Proctor*
(distance) (direction) (nearest town)

WELL PURPOSE: *Home*
(home, irrigation, municipal, industrial)


WELL COMPLETION DATA:
(1) diameter (inches) *4"*
(2) total depth (feet) *94*
(3) static water level (feet) *75* below top of ground.
(4) casing *Plastic Bottom*
(material) (depth)
(size) If telescope see back.
(5) screen *6'* *85*
(length) (depth to top)
4" *Plastic*
(size) (material)
(6) pump *General*
(HP) (yield gpm)
Pump
(type power)
(7) electric log *No*
(yes or no)
(organization running log)
(8) how well bottom plugged *No*

description of formations encountered	from	to
<i>Clay</i>	<i>0</i>	<i>13</i>
<i>chalky</i>	<i>13</i>	<i>55</i>
<i>sand</i>	<i>55</i>	<i>85</i>
<i>Sand & Gravel</i>	<i>85</i>	<i>94</i>
CODED		
FEB 5 1971		
MISS. BD. OF WATER COMMISSIONERS		

DRILLERS REMARKS:
old well dry -

If well telescopes please sketch and show depths.

GROUND LEVEL

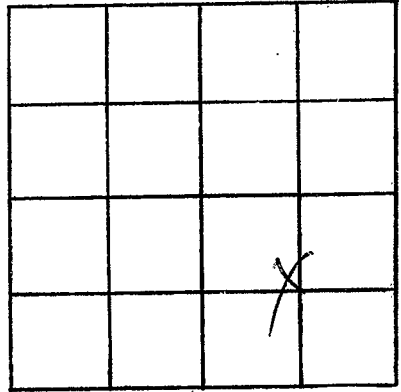

SECTION 4

Please indicate well location X.

ADDITIONAL INFORMATION

If more than one screen, show locations of each on sketch.