

PIKE  
M 36  
12-9-70

MISSISSIPPI  
BOARD OF WATER COMMISSIONERS  
416 North State Street  
Jackson, Mississippi 39201

**CODED**

WATER-WELL DRILLERS LOG

Dec 9 1970 Chester Kennes Pike  
date well completed firm name county well located

LANDOWNER: Mrs. Norma Meadows  
RFD 2 Box A - McLamb  
(mailing address)

WELL LOCATION:  
sec. 22 T. 1 N. R. 9 E.  
7 1/2 miles SE of Progers  
(distance) (direction) (nearest town)

WELL PURPOSE: Home  
(home, irrigation, municipal, industrial)

WELL COMPLETION DATA:  
(1) diameter (inches) 4"  
(2) total depth (feet) 115  
(3) static water level (feet) 6 below top of ground.  
(4) casing Plastic Bottom  
(material) (depth)  
(size) if telescope see back.  
(5) screen 6' 10'  
(length) (depth to top)  
4" Plastic  
(size) (material)  
(6) pump By owner  
(HPI) (yield gpm)  
(type power)  
(7) electric log NO-  
(yes or no)

(organization running log)  
(8) how well bottom plugged  
wooden plug

DRILLERS REMARKS:  
old well had

description of formations encountered	from	to
clay	0	10
sand	10	20
chuck	20	50
sand	50	90
sand & gravel	90	115


**CODED**

FEB 9 1971

MISS. Bd. of  
WATER COMMISSIONERS

If well telescopes please sketch and show depths.

GROUND LEVEL

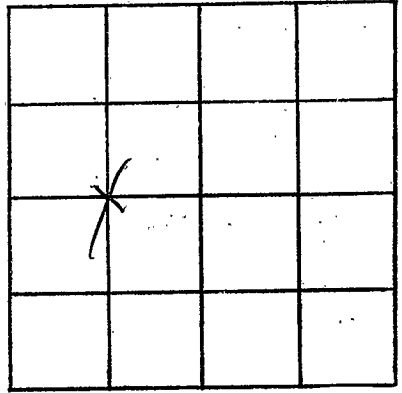

SECTION 22

Please indicate well location X.

ADDITIONAL INFORMATION

If more than one screen,  
show locations of each on sketch.