

PIKE  
M37  
1-29-71

MISSISSIPPI  
BOARD OF WATER COMMISSIONERS  
416 North State Street  
Jackson, Mississippi 39201

**CODED**

WATER WELL DRILLERS LOG

1-29 1971 *Fitzgerald*  
date well completed firm name county well located *Pike*

LANDOWNER:	description of formations encountered	from	to
<i>Charles Simmons</i>			
<i>R.R. Mayhew</i> (mailing address)	<i>red clay brown sandstone</i>	<i>0 20</i>	<i>70 102</i>
<b>WELL LOCATION:</b>			
sec. <u>4</u> T. <u>1</u> (N) R. <u>9</u> (E) <u>4</u> miles <u>NE</u> of <u>Jackson</u> (distance) (direction) (nearest town)			
<b>WELL PURPOSE:</b> <u>Home</u> (home, irrigation, municipal, industrial)			
<b>WELL COMPLETION DATA:</b>			
(1) diameter (inches) <u>4</u>			
(2) total depth (feet) <u>102</u>			
(3) static water level (feet) <u>70</u> below above top of ground.			
(4) casing <u>plastic</u> , <u>96</u> (material) (depth)			
<u>4</u> if telescope see back. (size)			
(5) screen <u>96</u> , <u>96</u> (length) (depth to top)			
<u>4</u> , <u>plastic</u> (size) (material)			
(6) pump <u>1/2</u> , <u>8</u> (HP) (yield gpm)			
<u>el</u> (type power)			
(7) electric log <u>ny</u> (yes or no)			
(organization running log)			
(8) how well bottom plugged <u>wood chips</u>			
<b>DRILLERS REMARKS:</b>			


**CODED**

FEB 11 1971

MISS. BU. OF  
WATER CONTROL

If well telescopes please sketch and show depths.

GROUND LEVEL

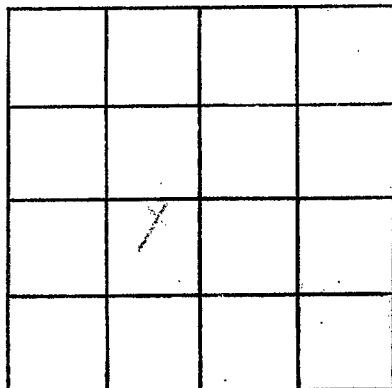

SECTION 4

Please indicate well location X.

ADDITIONAL INFORMATION

If more than one screen,  
show locations of each on sketch.