

Pike
M38
7-9-69

MISSISSIPPI
BOARD OF WATER COMMISSIONERS
416 North State Street
Jackson, Mississippi 39201

CODED

WATER WELL DRILLERS LOG

July 9 1969 Blumwell Pump Co Pike
date well completed firm name county well located

LANDOWNER: Edger Smith
RFD 4
Tylertown
(mailing address)

WELL LOCATION:
sec. 11 T. 1 N. R. 9 E
4 1/2 miles ENE of Blumwell
(distance) (direction) (nearest town)

WELL PURPOSE: Drain
(home, irrigation, municipal, industrial)

WELL COMPLETION DATA:

- (1) diameter (inches) 4"
- (2) total depth (feet) 134
- (3) static water level (feet) 90 below above top of ground.
- (4) casing Plastic Bottom
(material) (depth)
6' If telescope see back.
(size)
- (5) screen 6' 128'
(length) (depth to top)
4" Plastic
(size) (material)
- (6) pump 1/2 HP Sub 12
(HP) (yield gpm)
Steel
(type power)
- (7) electric log no
(yes or no)
- (organization running log)
- (8) how well bottom plugged
Bottom

description of formations encountered	from	to
<u>Red clay</u>	<u>0</u>	<u>14</u>
<u>Red Sand Clay</u>	<u>14</u>	<u>70</u>
<u>Small gravel</u>	<u>70</u>	<u>87</u>
<u>Gravel</u>	<u>87</u>	<u>112</u>
<u>Creek sand</u>	<u>112</u>	<u>134</u>


CODED

SEP 16 1969
MISS. BR.
WATER COM.

DRILLERS REMARKS:
NO PREVIOUS WELL

If well telescopes please sketch and show depths.

GROUND LEVEL

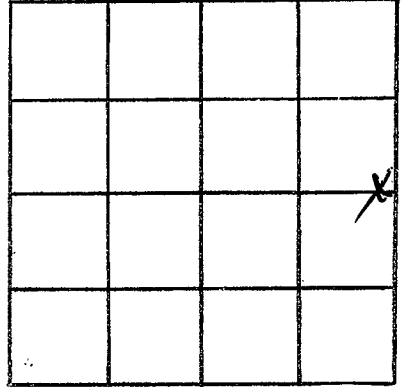

SECTION 11

Please indicate well location X.

ADDITIONAL INFORMATION

If more than one screen,
show locations of each on sketch.