

PIKE  
M 40  
10-17-69

MISSISSIPPI  
BOARD OF WATER COMMISSIONERS  
416 North State Street  
Jackson, Mississippi 39201

**CODED**

WATER WELL DRILLERS LOG

11-17 1969 Fitzgerald well Rebe  
date well completed firm name county well located

LANDOWNER:  
Mitchell Waver  
R.R. Magnolia, Miss.  
(mailing address)

description of formations encountered	from	to
<u>Red clay</u>	<u>0</u>	<u>20</u>
<u>Red sand</u>	<u>20</u>	<u>80</u>
<u>Red gravel</u>	<u>80</u>	<u>95</u>
<u>Coarse shell &amp; gravel</u>	<u>95</u>	<u>106</u>

WELL LOCATION:  
sec. 18 T 1 N R 9 E  
S W  
9 miles E of Magnolia  
(distance) (direction) (nearest town)

WELL PURPOSE: Home  
(home, irrigation, municipal, industrial)

- WELL COMPLETION DATA:
- (1) diameter (inches) 4
  - (2) total depth (feet) 106
  - (3) static water level (feet) 80 below above top of ground
  - (4) casing Plastic 95  
(material) (depth)
  - 4 If telescope see back.  
(size)
  - (5) screen 8 98  
(length) (depth to top)
  - 4 Plastic  
(size) (material)
  - (6) pump 10 10  
(HP) (yield gpm)
  - Gen  
(type power)
  - (7) electric log no  
(yes or no)
  - (organization running log)
  - (8) how well bottom plugged completely

**CODED**


NOV 21 1969

MISS. BD. OF  
WATER COM.

DRILLERS REMARKS:

If well telescopes please sketch and show depths.

GROUND LEVEL

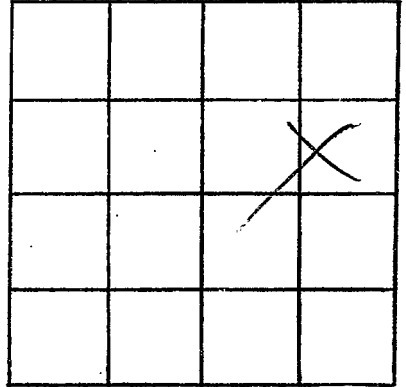

SECTION B

Please indicate well location X.

ADDITIONAL INFORMATION

If more than one screen,  
show locations of each on sketch.